

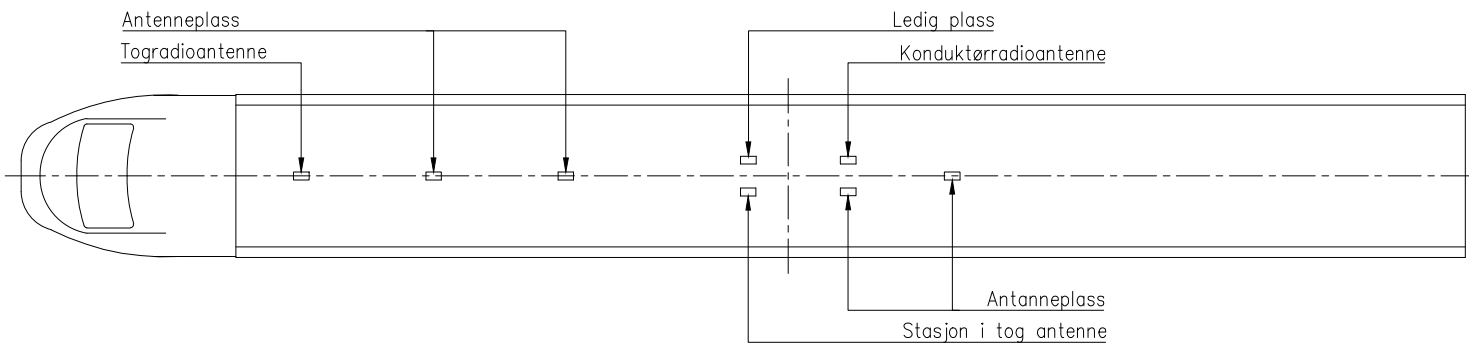
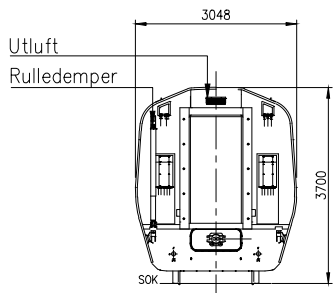
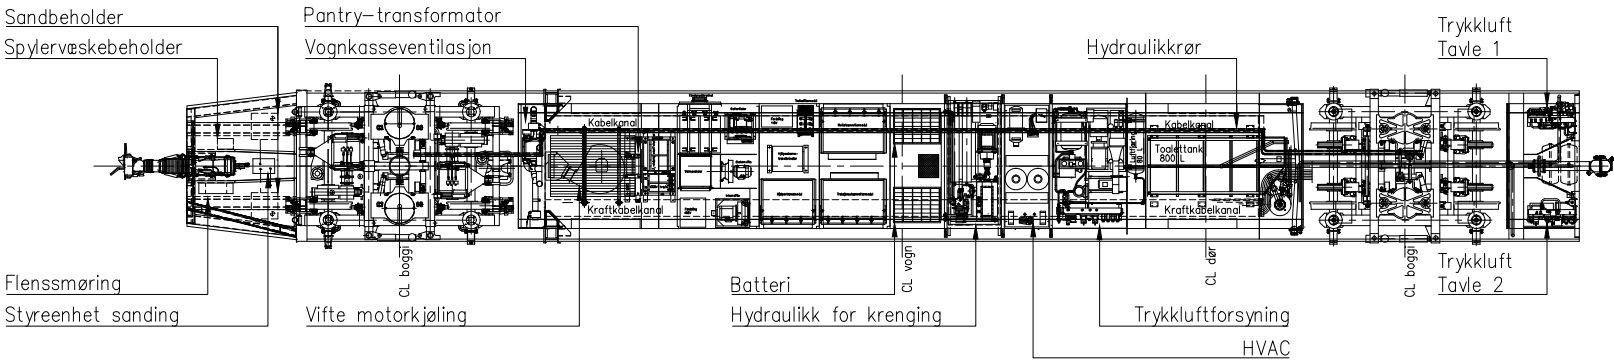
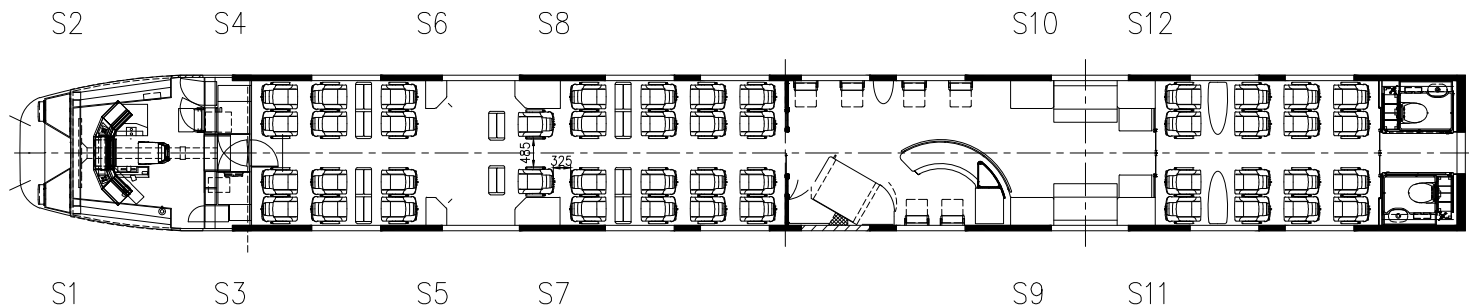


BM73B

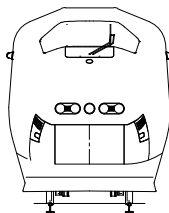

A-ende

B-ende

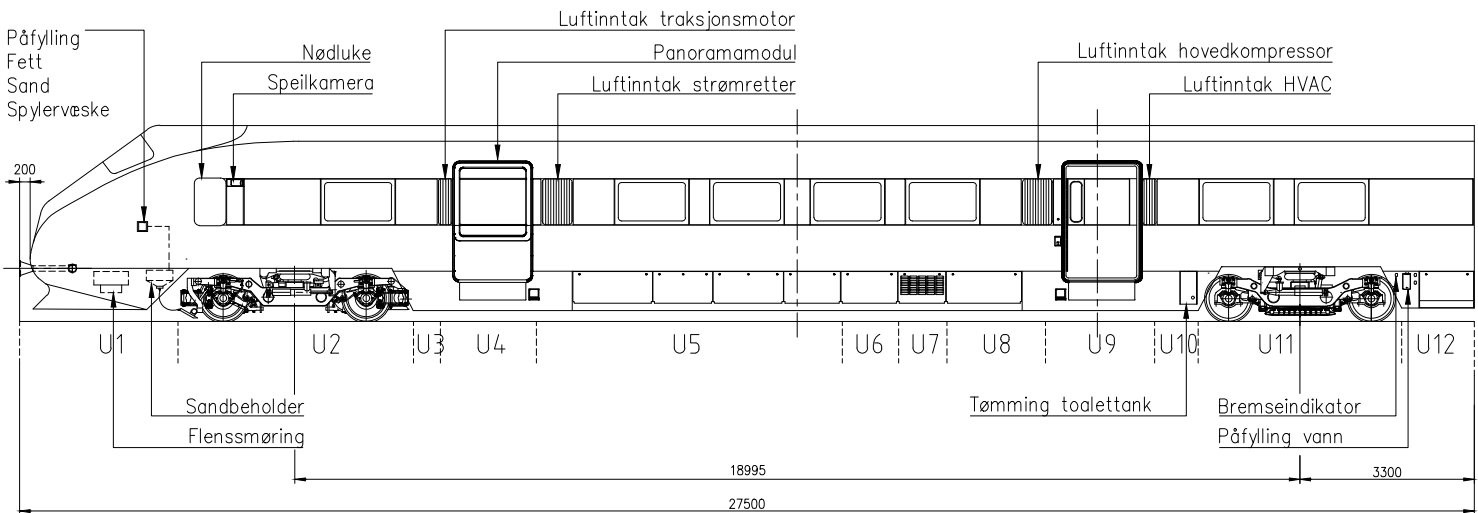

NOTES					
			SUPPLIER		
01	17.12.2021	Fjernet repeater	NT – ISB	NT – ØN	NT – SO
00	09.09.2019	Endelig utg. e. MUU	AG	MLa	VLA
Rev. no	Rev. date	Reason for issue	Prepared by	Checked by	Approved by
Replace doc no. T000_3EST 128-203_01			Scale 1:70		
			No sep. prts.list ☒		
			Prts.list same no. ☐		
			Prts.list other no. ☐		
Title Vognlayout BM73B				Sheet No.	No. of sheets
				Norske tog no. NOR0000428	

As built drawings shall not be used for manufacturing of any component, use and communication of information shall be limited to the information contained in this document.