


	Fiber datautak
	Dobbelt datautak påvegg
	Dobbelt datautak innfelt
	Dobbelt datautak Tak/over himling
	Dobbelt datautak Tak/over himling
	Rada pulse Dusysystem
	Fondetterskap, gulvvarme
	Dusj av/på PIR
	KNX-kabel
	MetraBUS
	XLR-kontakt
	Plassering aktive spjeld
	Punkt/koblingsboks
	Sikkerhetssensoren til Rada Pulse
	Riv 310 01 3- vegs motorstyrt Ventil.
	3GZ.5mm³ For Poseidon

Tegningsnummer: EP-3-500-6	Revisjon: Z-01
--------------------------------------	--------------------------

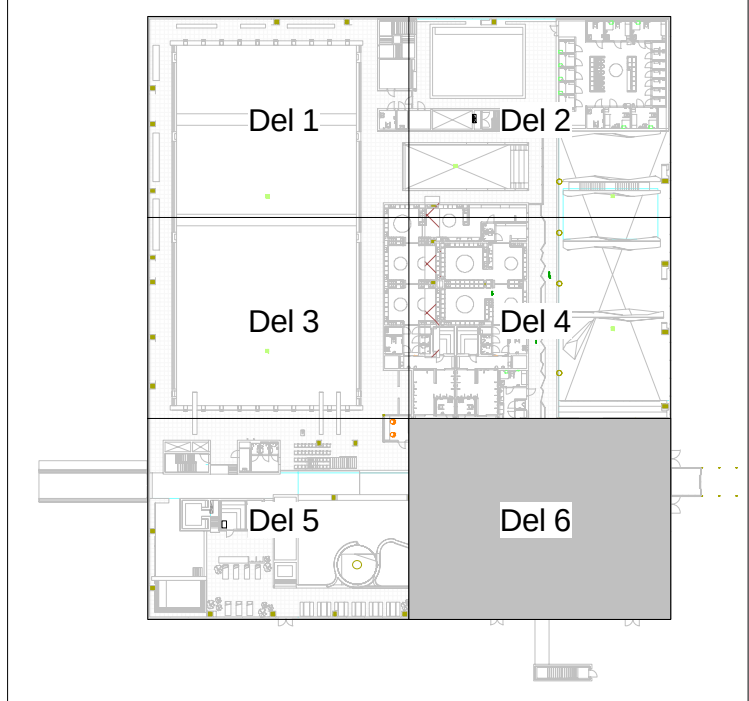

Z - 02	Som typsett	01.11.2019	KSL JN
Rev.	Tekst	Rev.dato:	Tegn. Ky.

Som bygget

	
Projekt Tromsøbadet	
Oprettelsesår Tromsø kommune, Utbyggingstjenesten	
Tele og Autom. Plan 3 Del 6	
Dokumentnr. Rune Langseth Tegningsnr. 543223-01	Koordinatensystem NTM 18 Høydeangivelse NN 54
Skala EP-3-500-6 Filnavn Tele og Autom.	Arkivnavn I:50 Arkivkode A0 Dato Z-01