
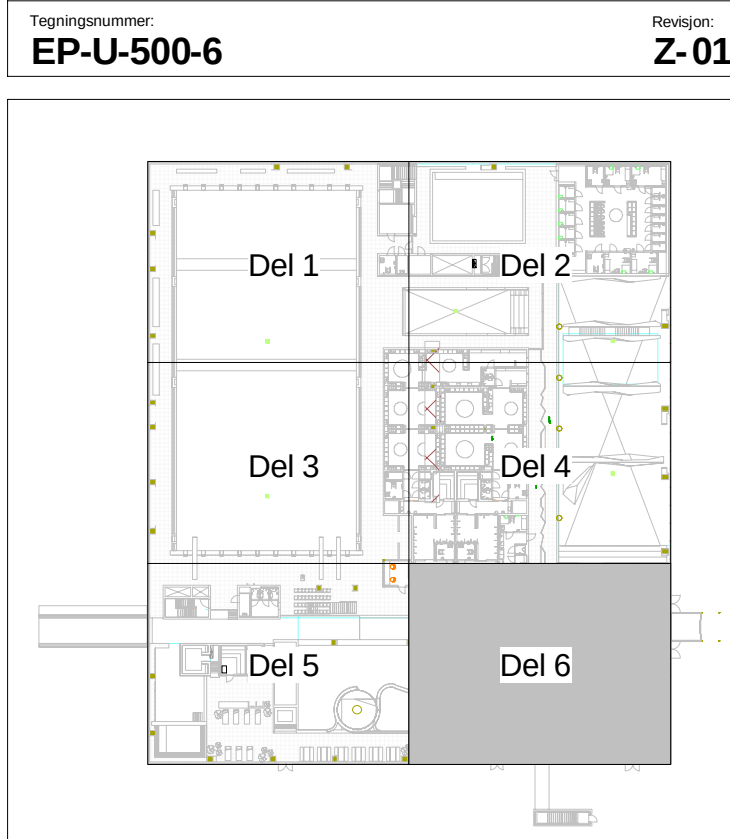


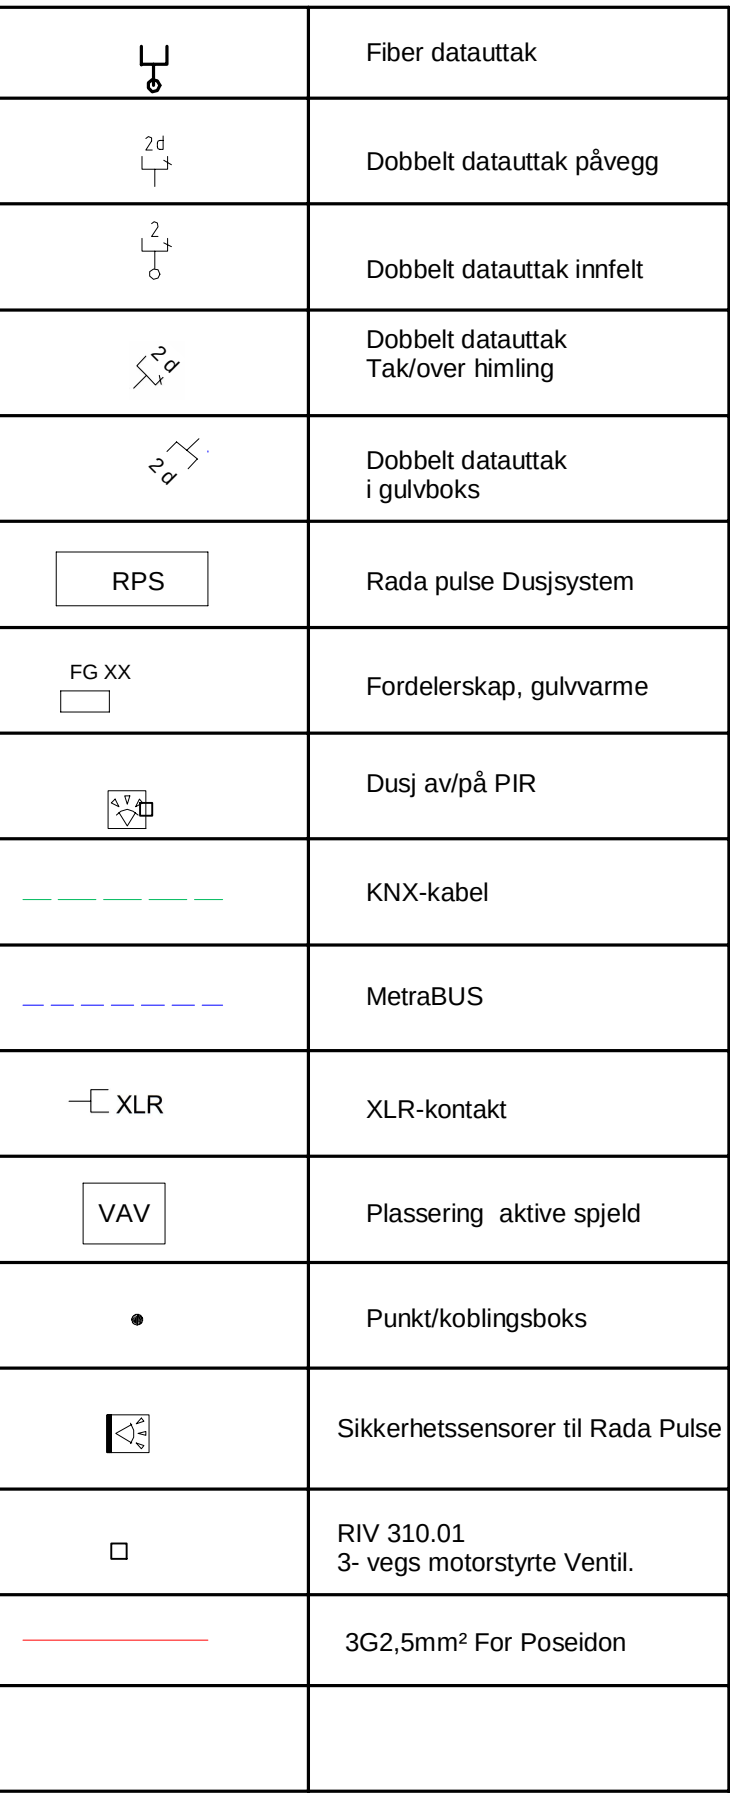

Z - 01	Sonn hyppet	01.11.2019	K26
Rev.	Treist	Rev.dat:	Tags ko

Som bygget	
------------	--

 asplan viak

Prosjekt
Tromsøbadet

Oppdragsgjeter:
Tromsø kommune, Utbyggingstjenesten

Tele og Autom. Plan U Del 6

Oppringslader: Rune Langseth	Koordinatsystem: NTM 18	Målestokk: 1 : 50
Oppringsnr.: 534323-01	Handteiknare: NN 54	Akkordnr: A0

Tegn. nr.:	Rev.
EP-U-500-6	Z-01
Følg Type B3a, Løseer.	