


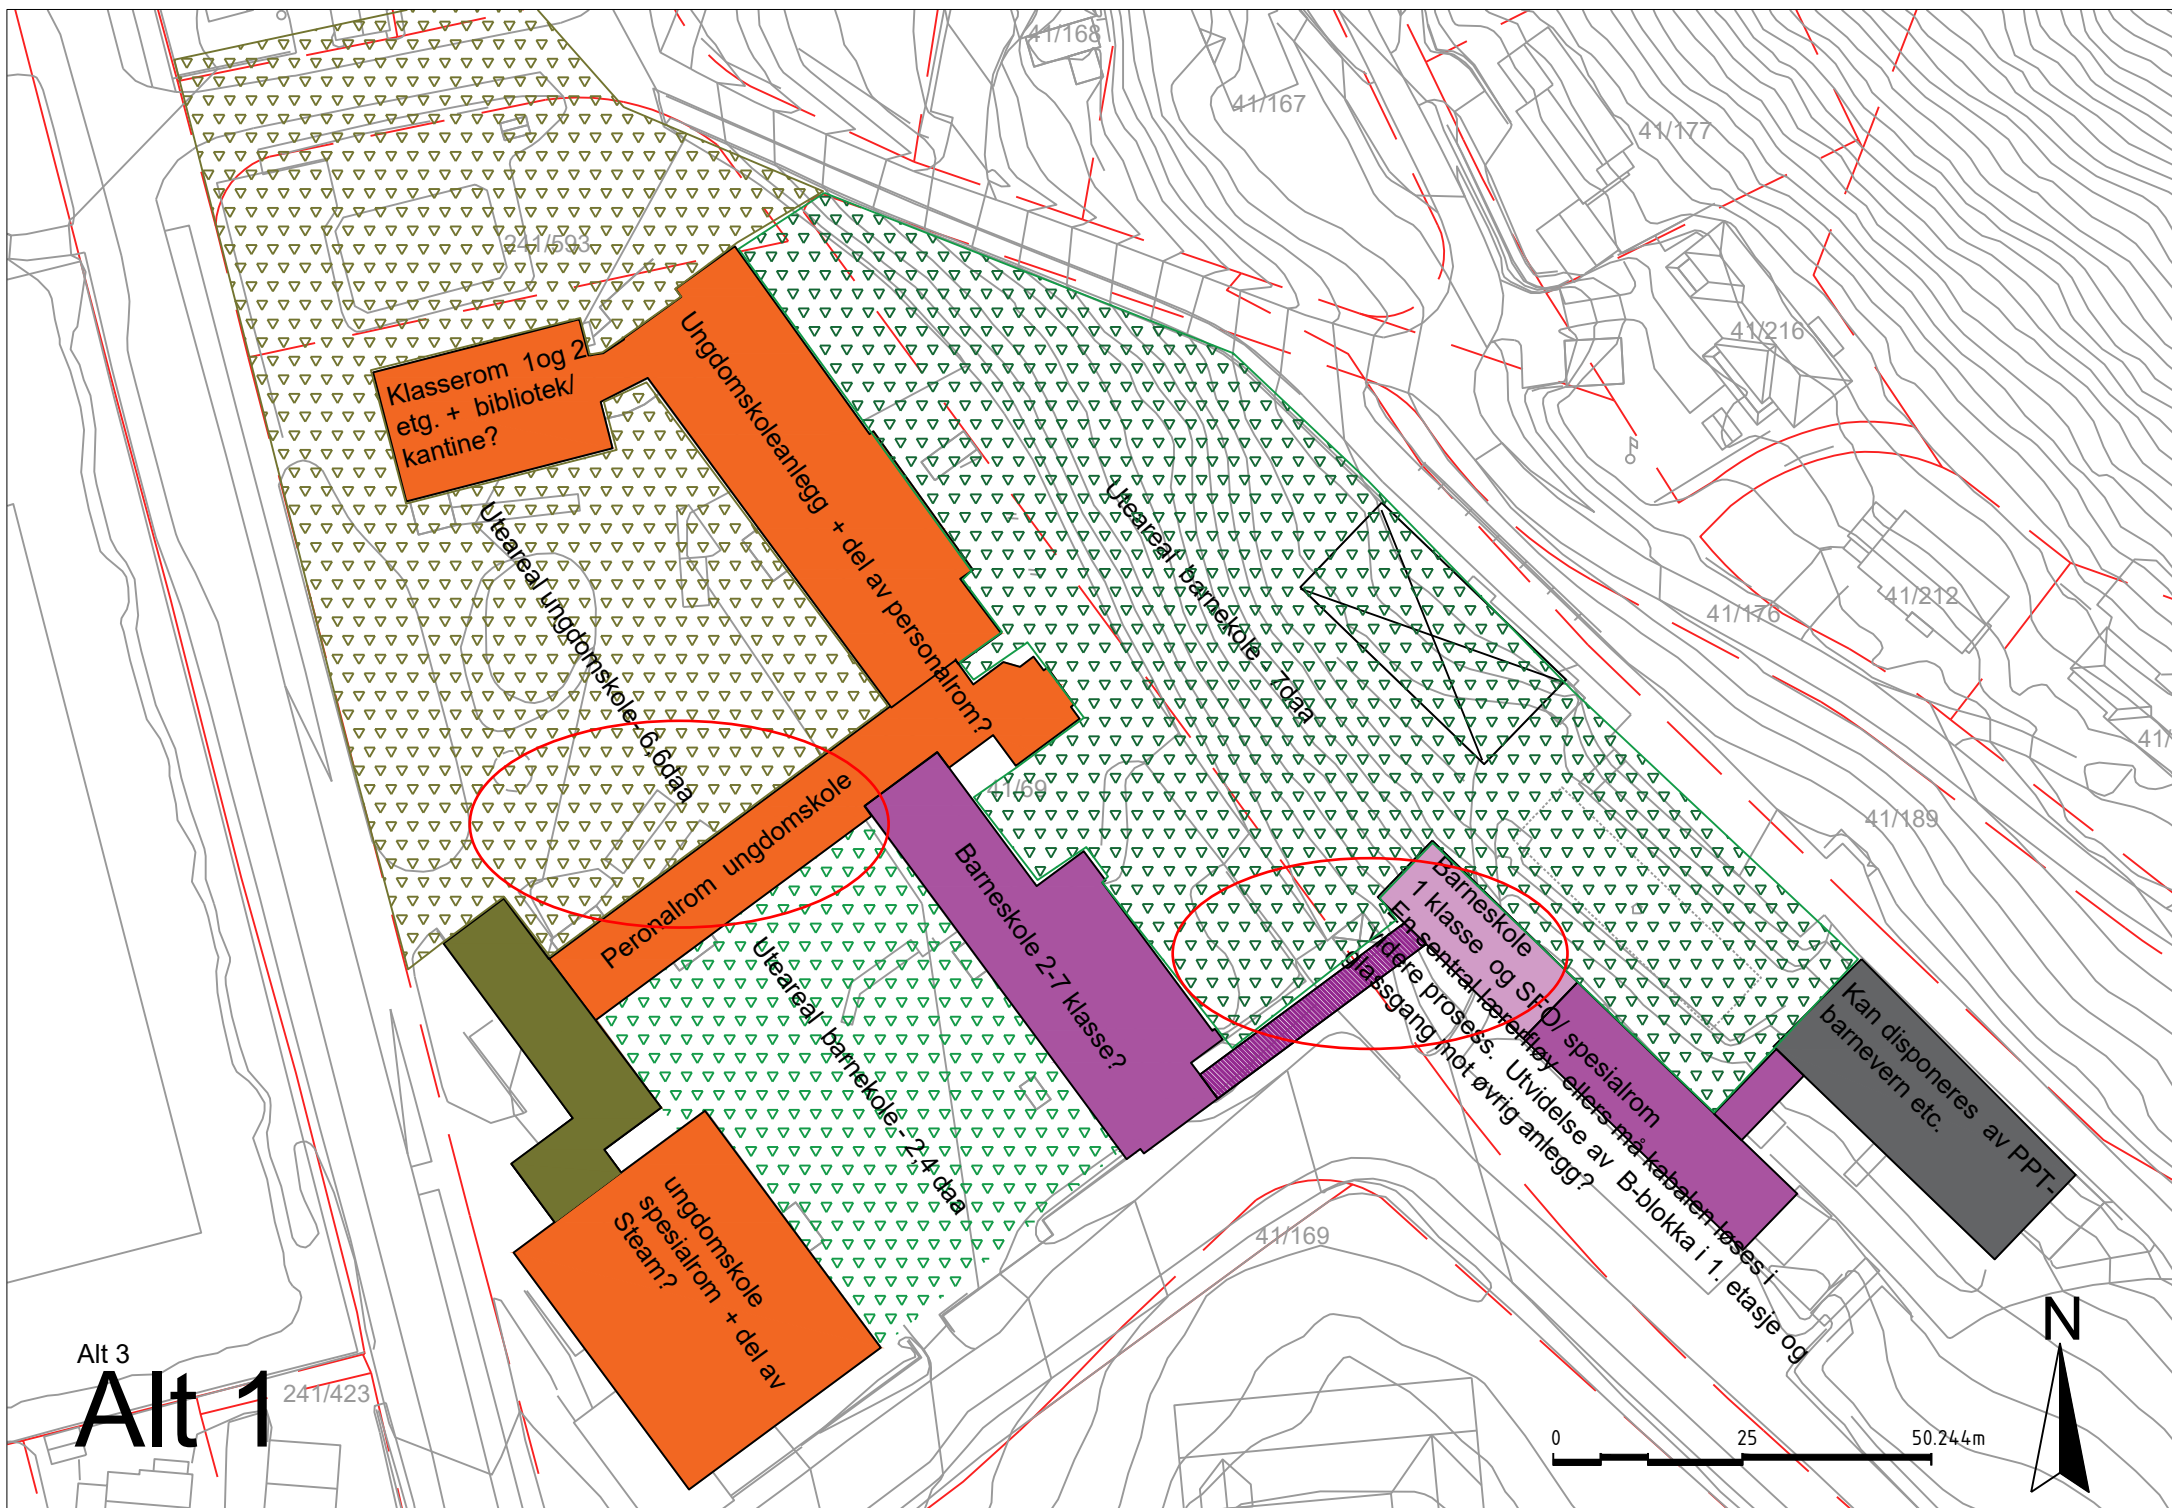

Alt 3
Alt 1

241/423