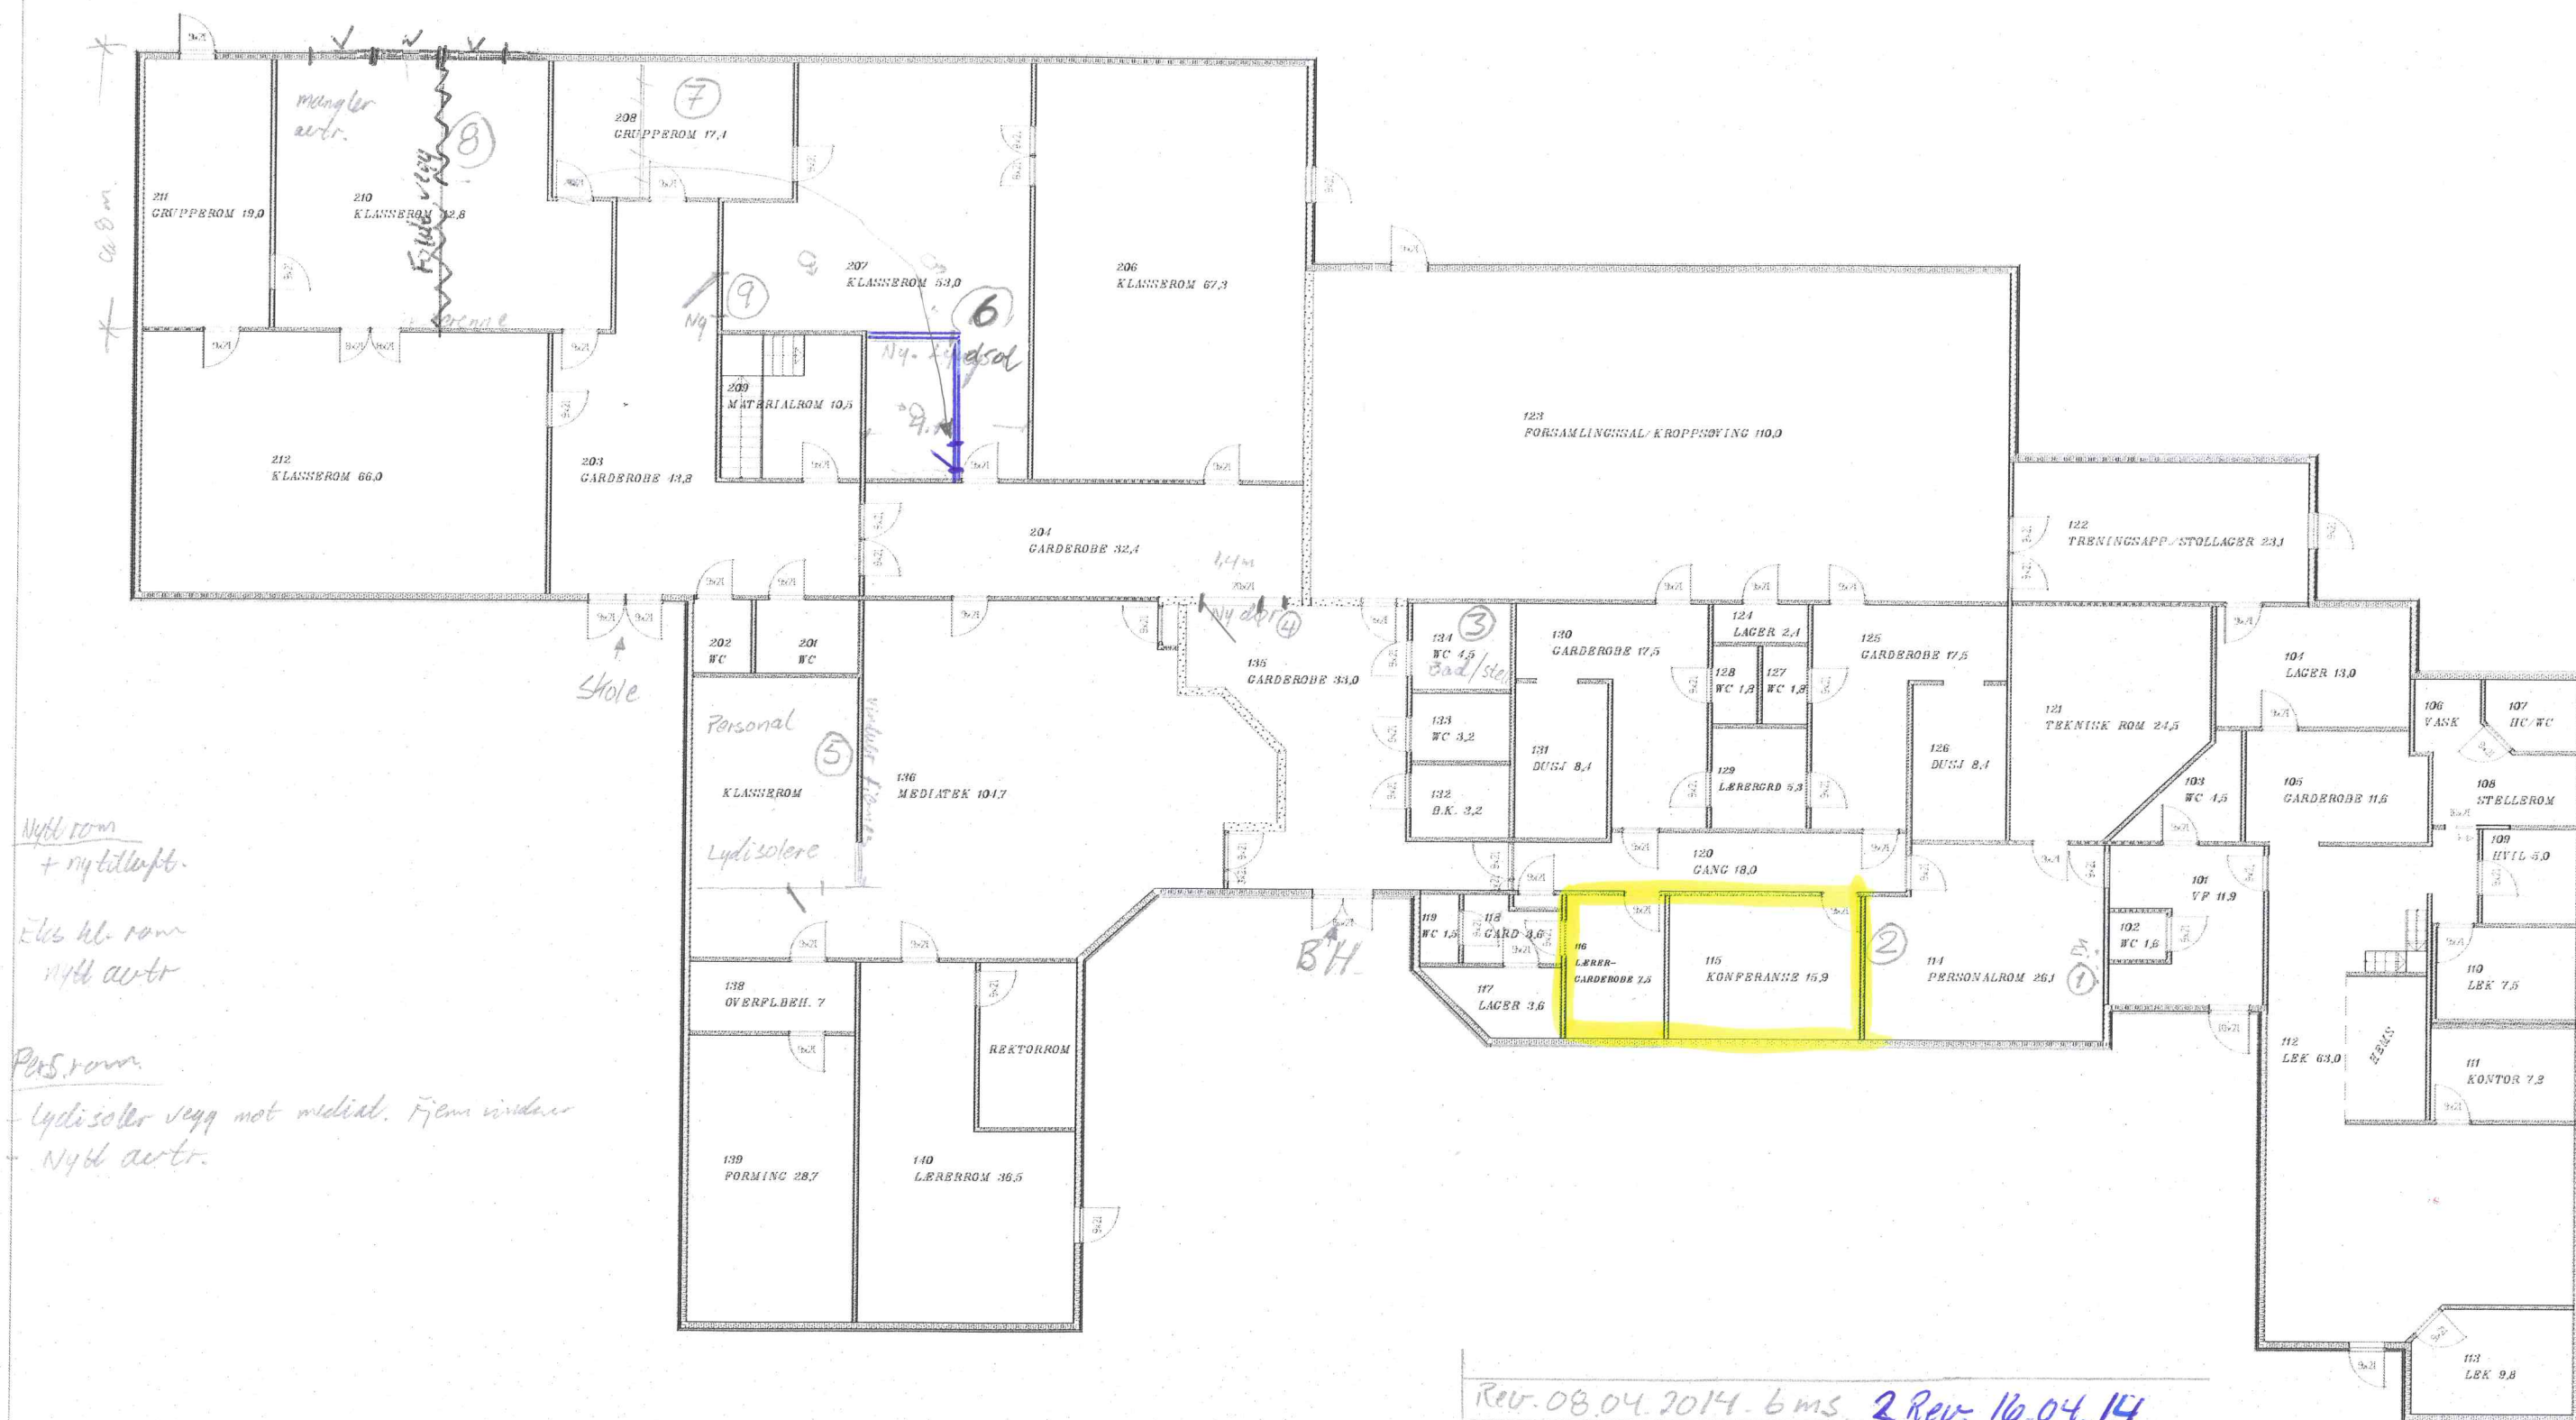



$$Etgh. = 2.75 \text{ m.}$$


Rev. 08.04.2014 - 6 ms 2 Rev. 16.04.14  
Ombygging, mere bh. plasser

	Tiltakshaver:		DATA DESIGN SYSTEM	
	Byggeplass:	Øvre Rindal	Dato:	28.11.2003
	Kommune:	Rindal Kommune	Tegn:	fore
	Gnr:	Bnr:	Prosjekt:	Øvre
	Mål: 1 : 100		Tegnning:	501
Sammenstille ark 1				