
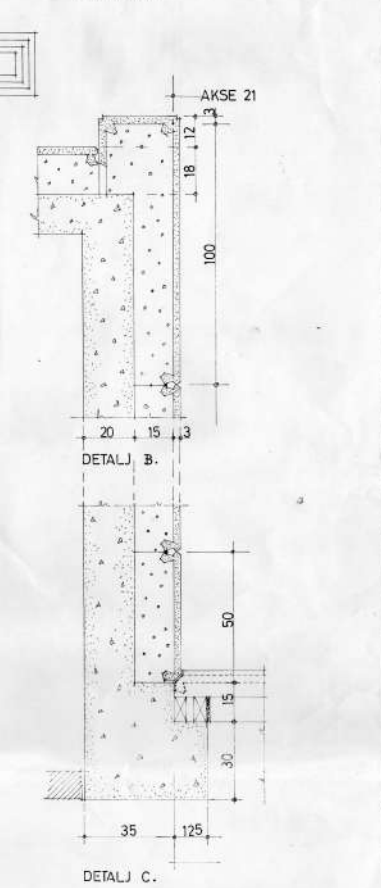
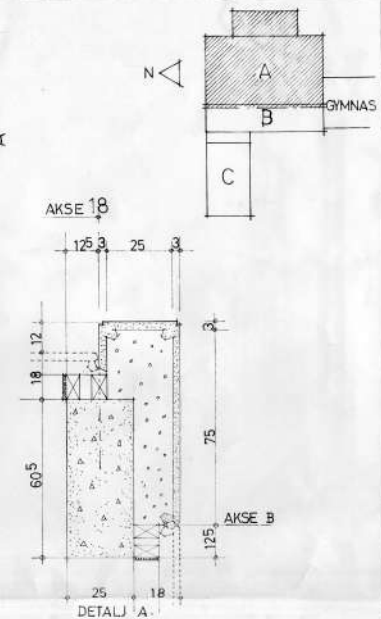


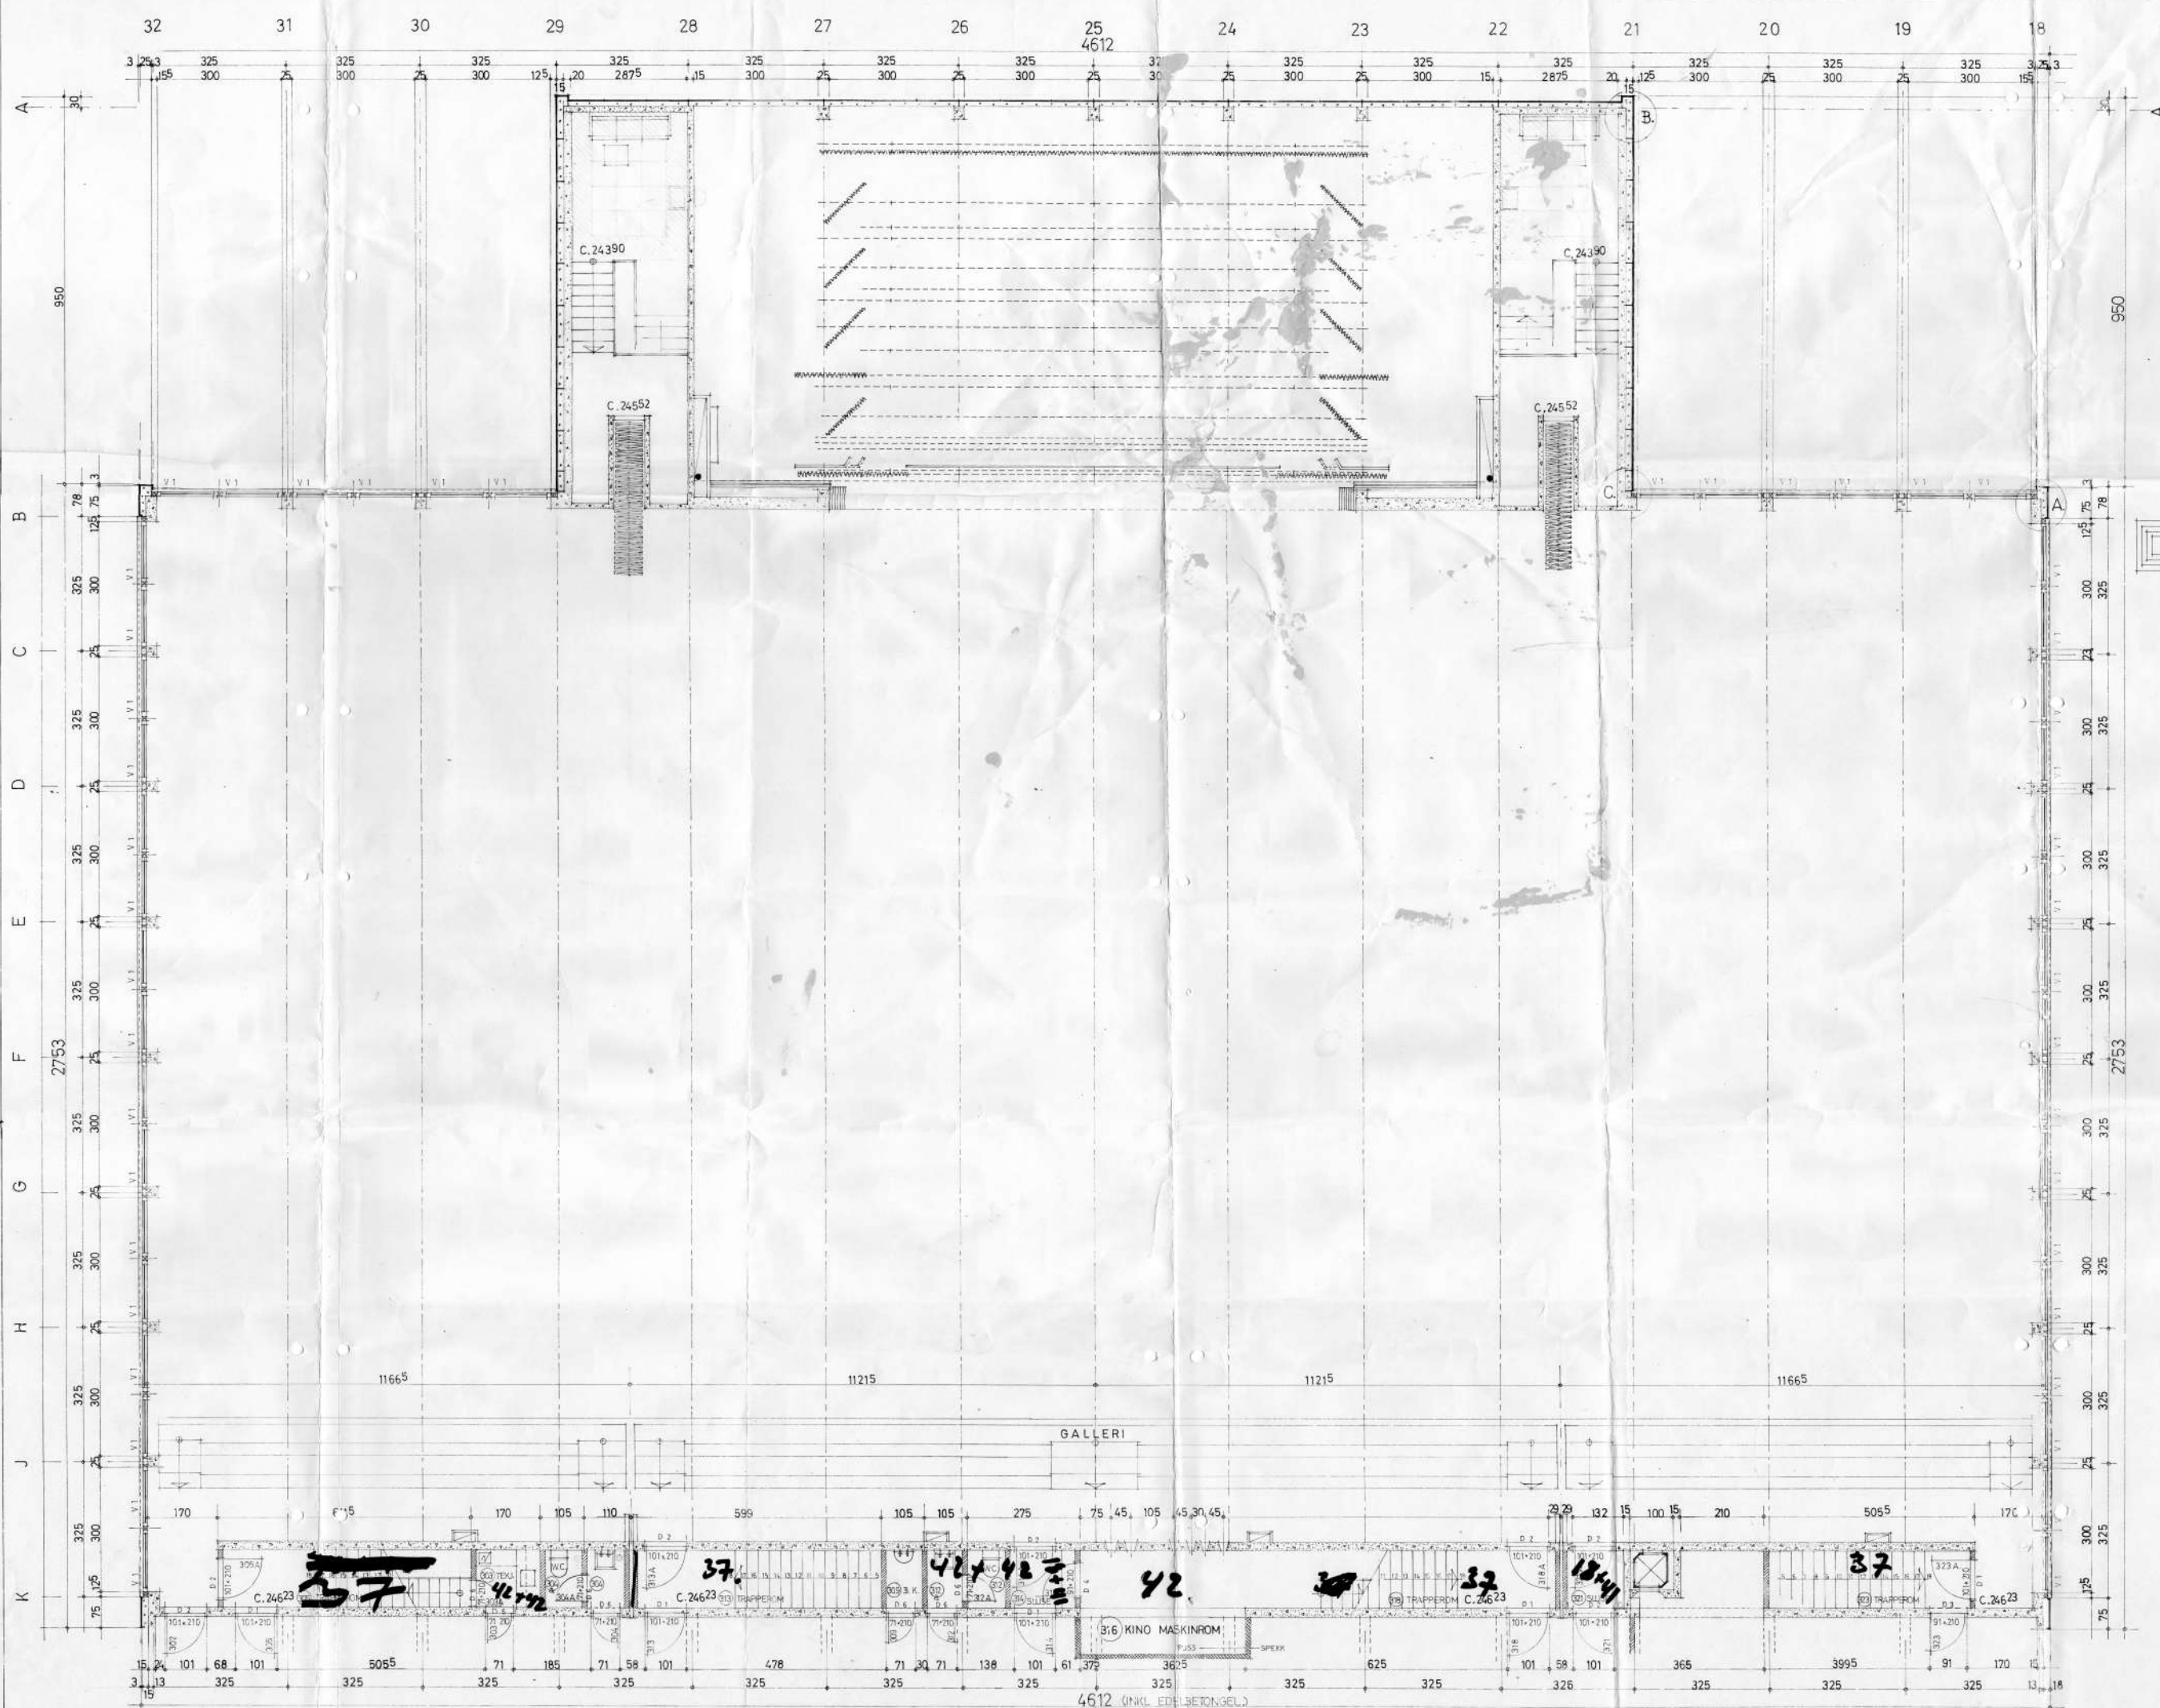

3.