
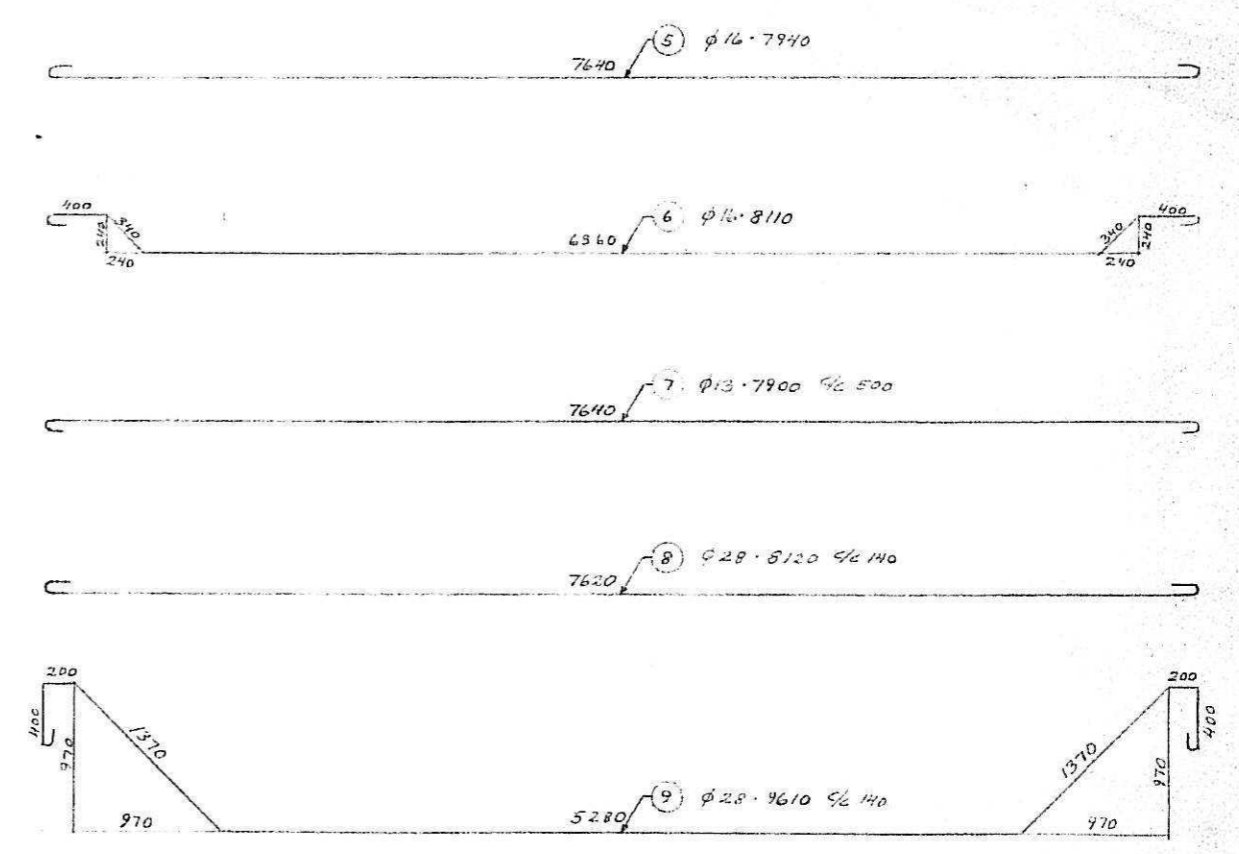
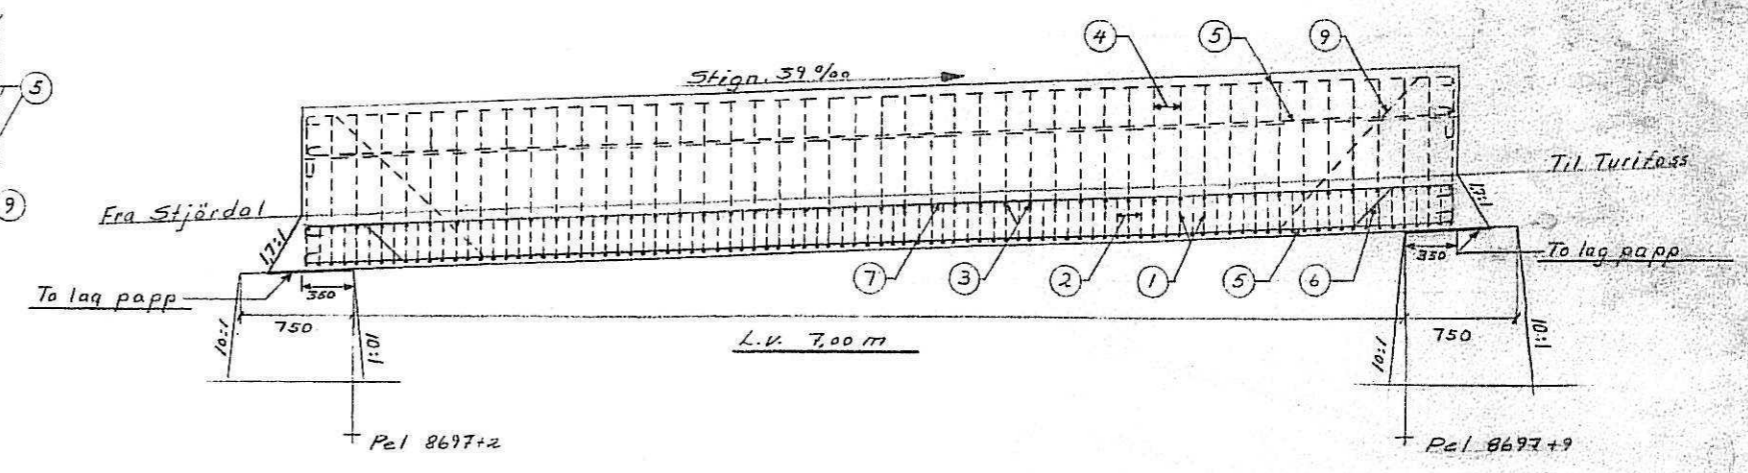


Tverrarmering.

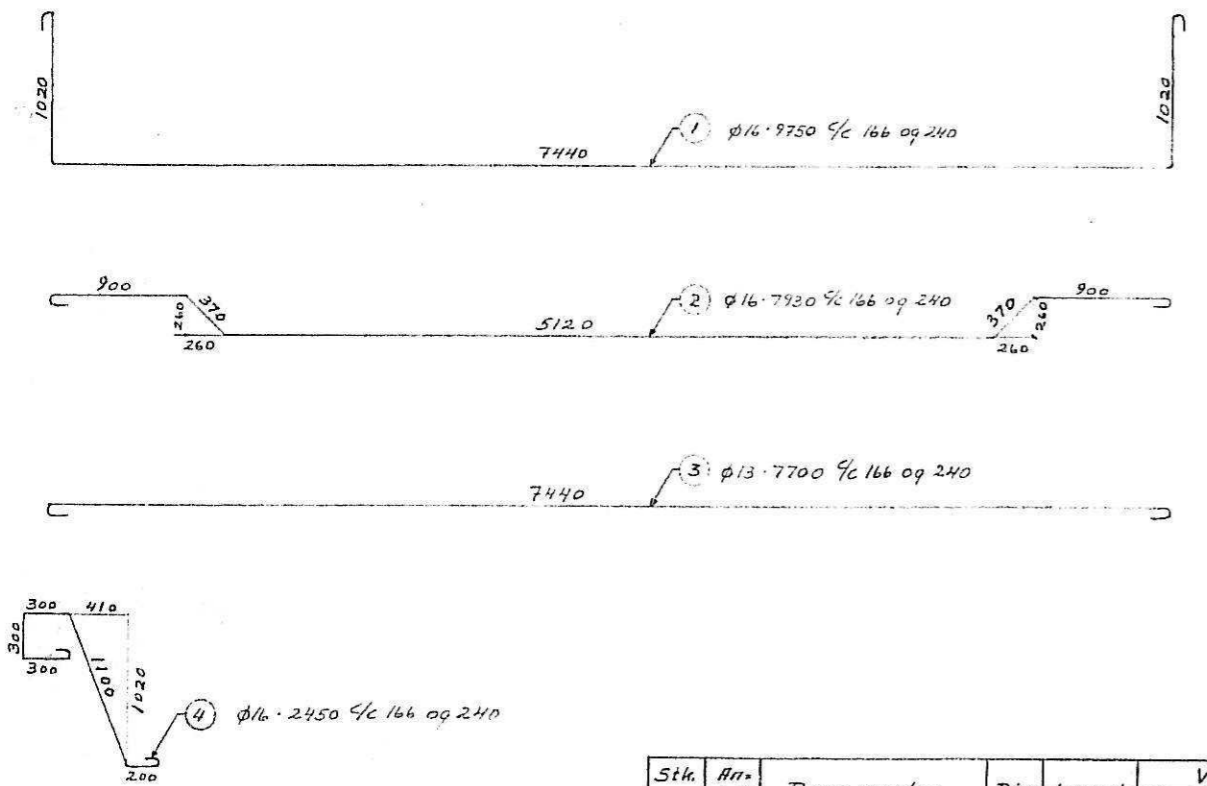

Stk. nr.	An. tall	Benevnelse	Dim. mm	Lengde m	Vekt i kg			
					pr. m	pr. stk.	ialt	
1	47	Tverrarmering	16	9750	1,578	15,40	724	
2	46	"	"	7930	"	12,52	576	
3	47	"	13	7700	1,042	8,02	377	
4	94	Sidekantarm.	16	2450	1,578	3,87	364	
5	43	Lengdearmering	"	7940	"	12,53	539	
6	18	"	"	8110	"	12,20	230	
7	14	"	13	7900	1,042	8,24	116	
8	8	Sidekantarm.	28	8120	4,834	39,25	314	
9	6	"	"	9610	"	46,50	279	
Surringstråd							16	

Sum = 3535 kg

Betong kvalitet B ca. 25,5 m³ og ca. 170 seker sement

6485 NR. 10577

TEVLA BRU		M	Tegn. Psh.
ARMERINGSTEGNING		1:25	Tegn. Ktr.
ANLEGGSKTR. STJØR-			
DAL. DEN 12/6-1957.			
Overvåk.		K 20	