



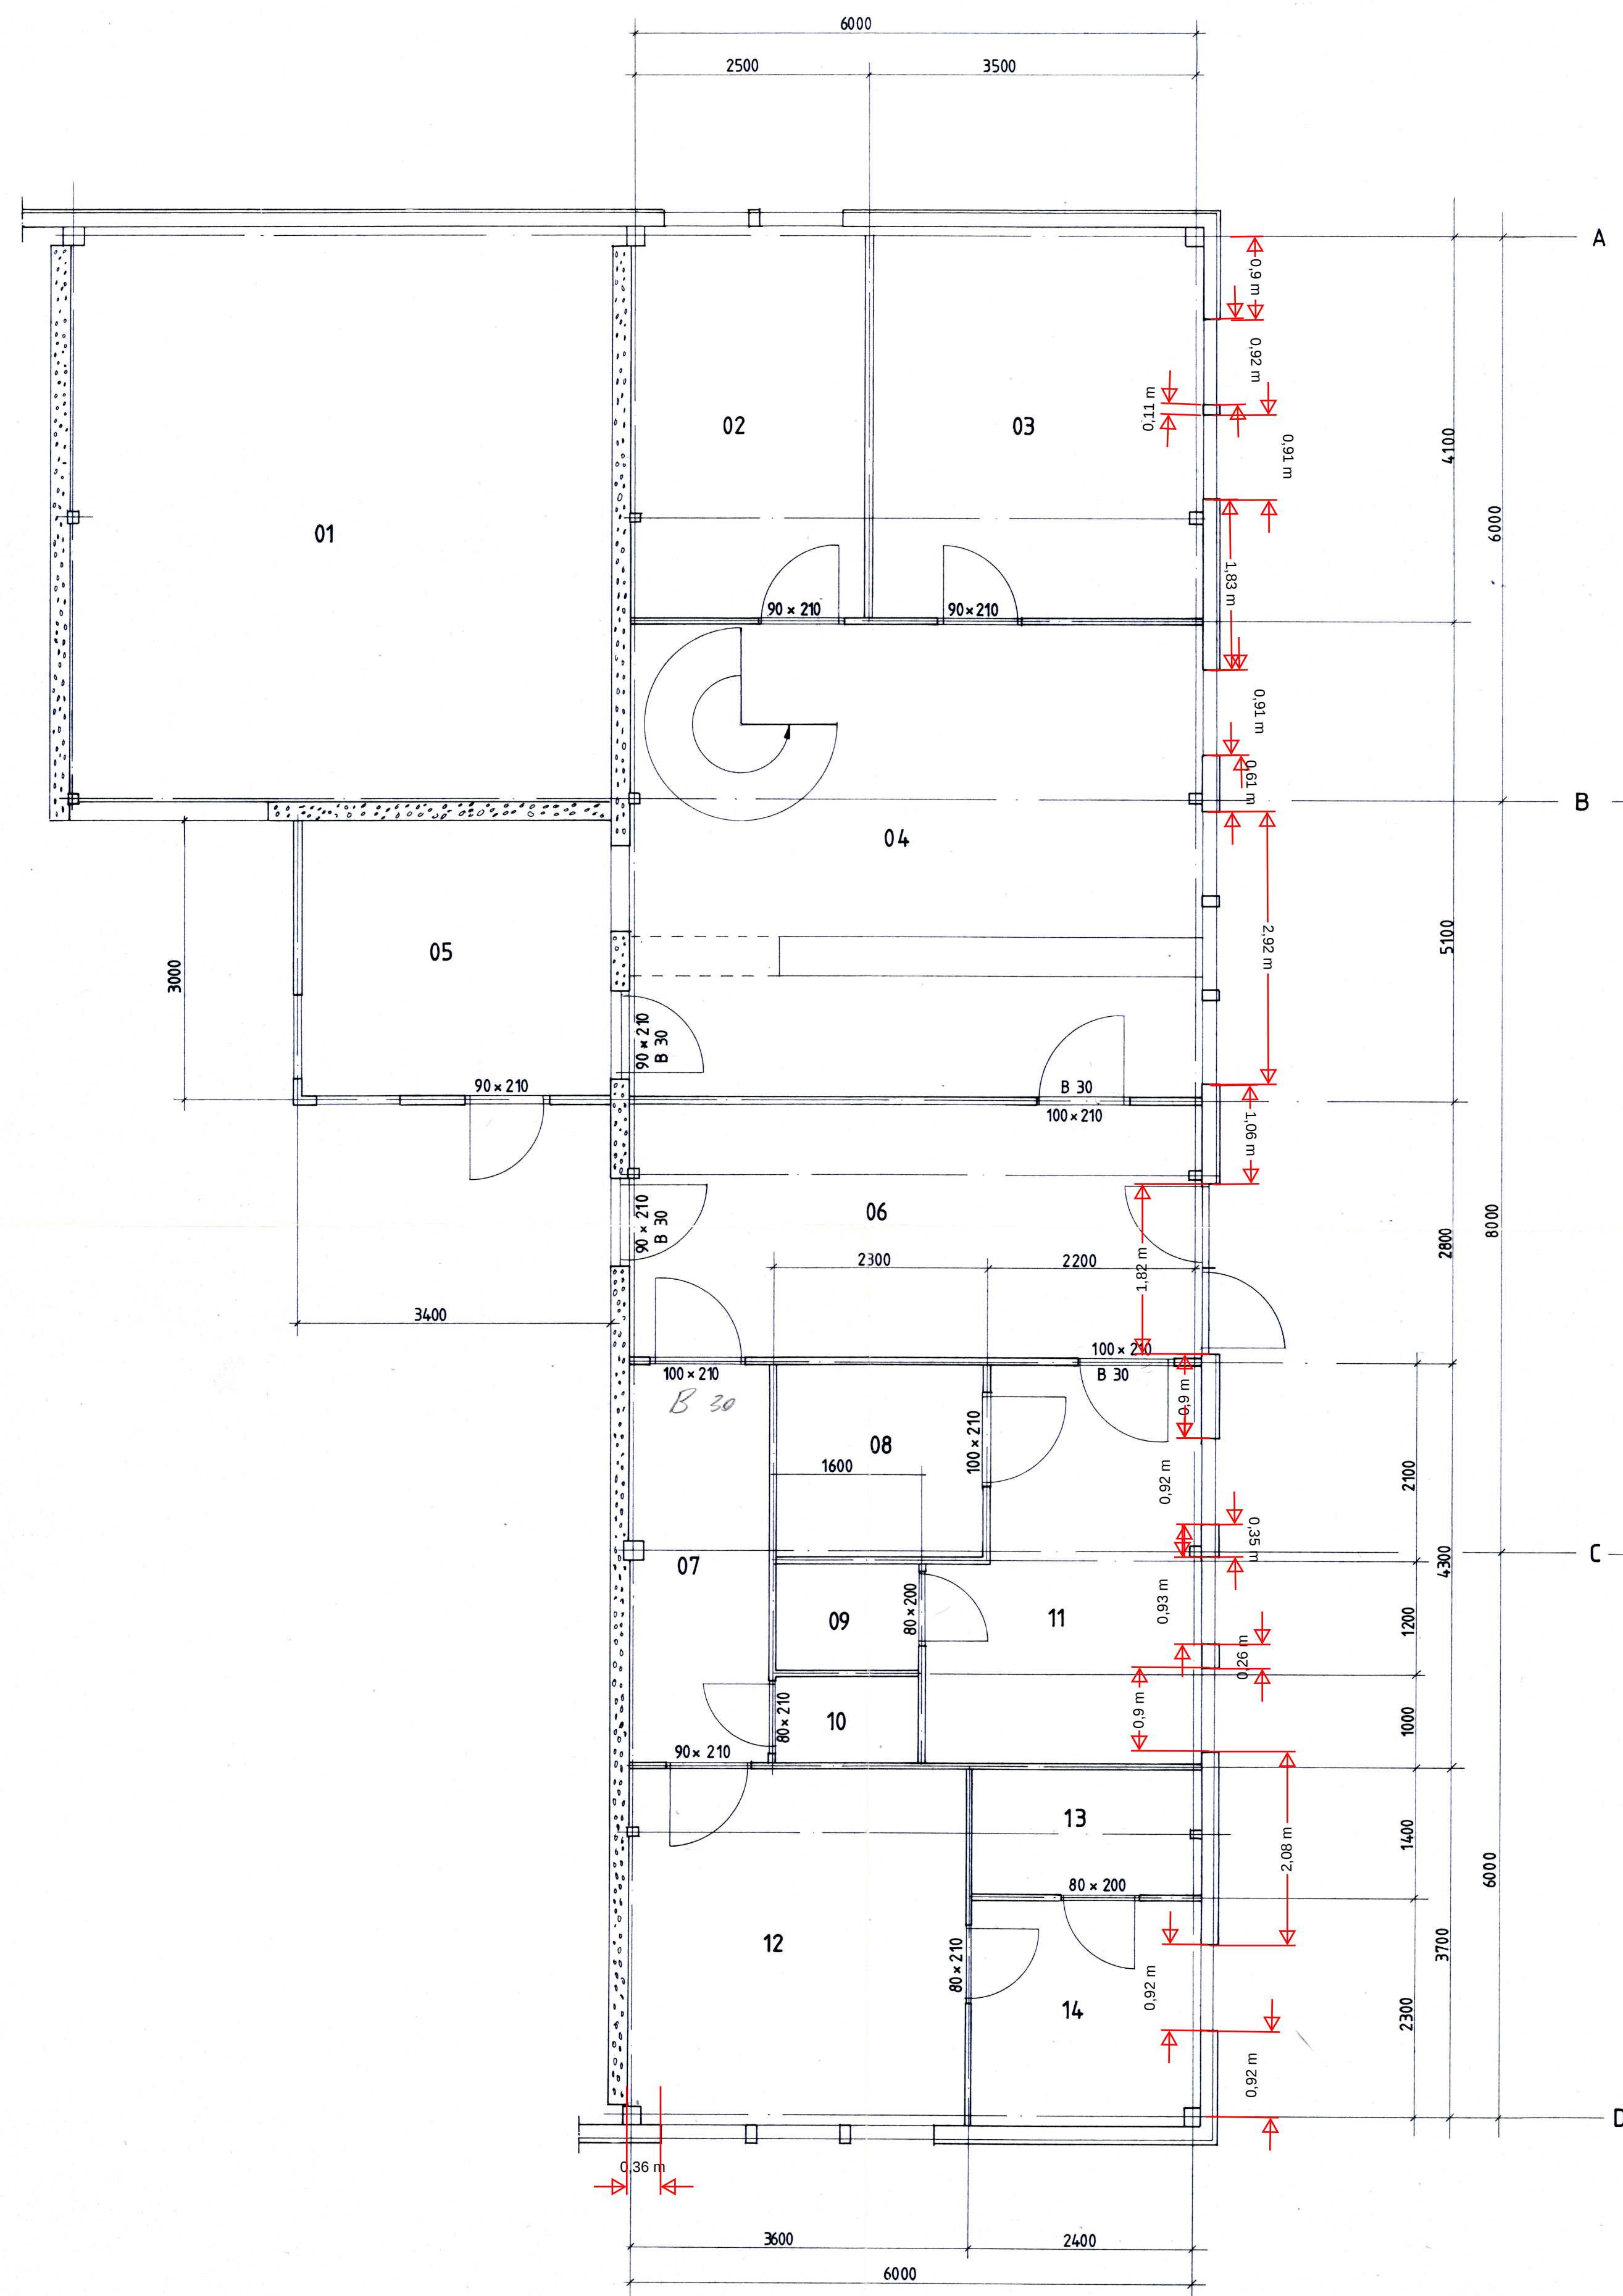

PLAN 1. ETG. (M 1:50)

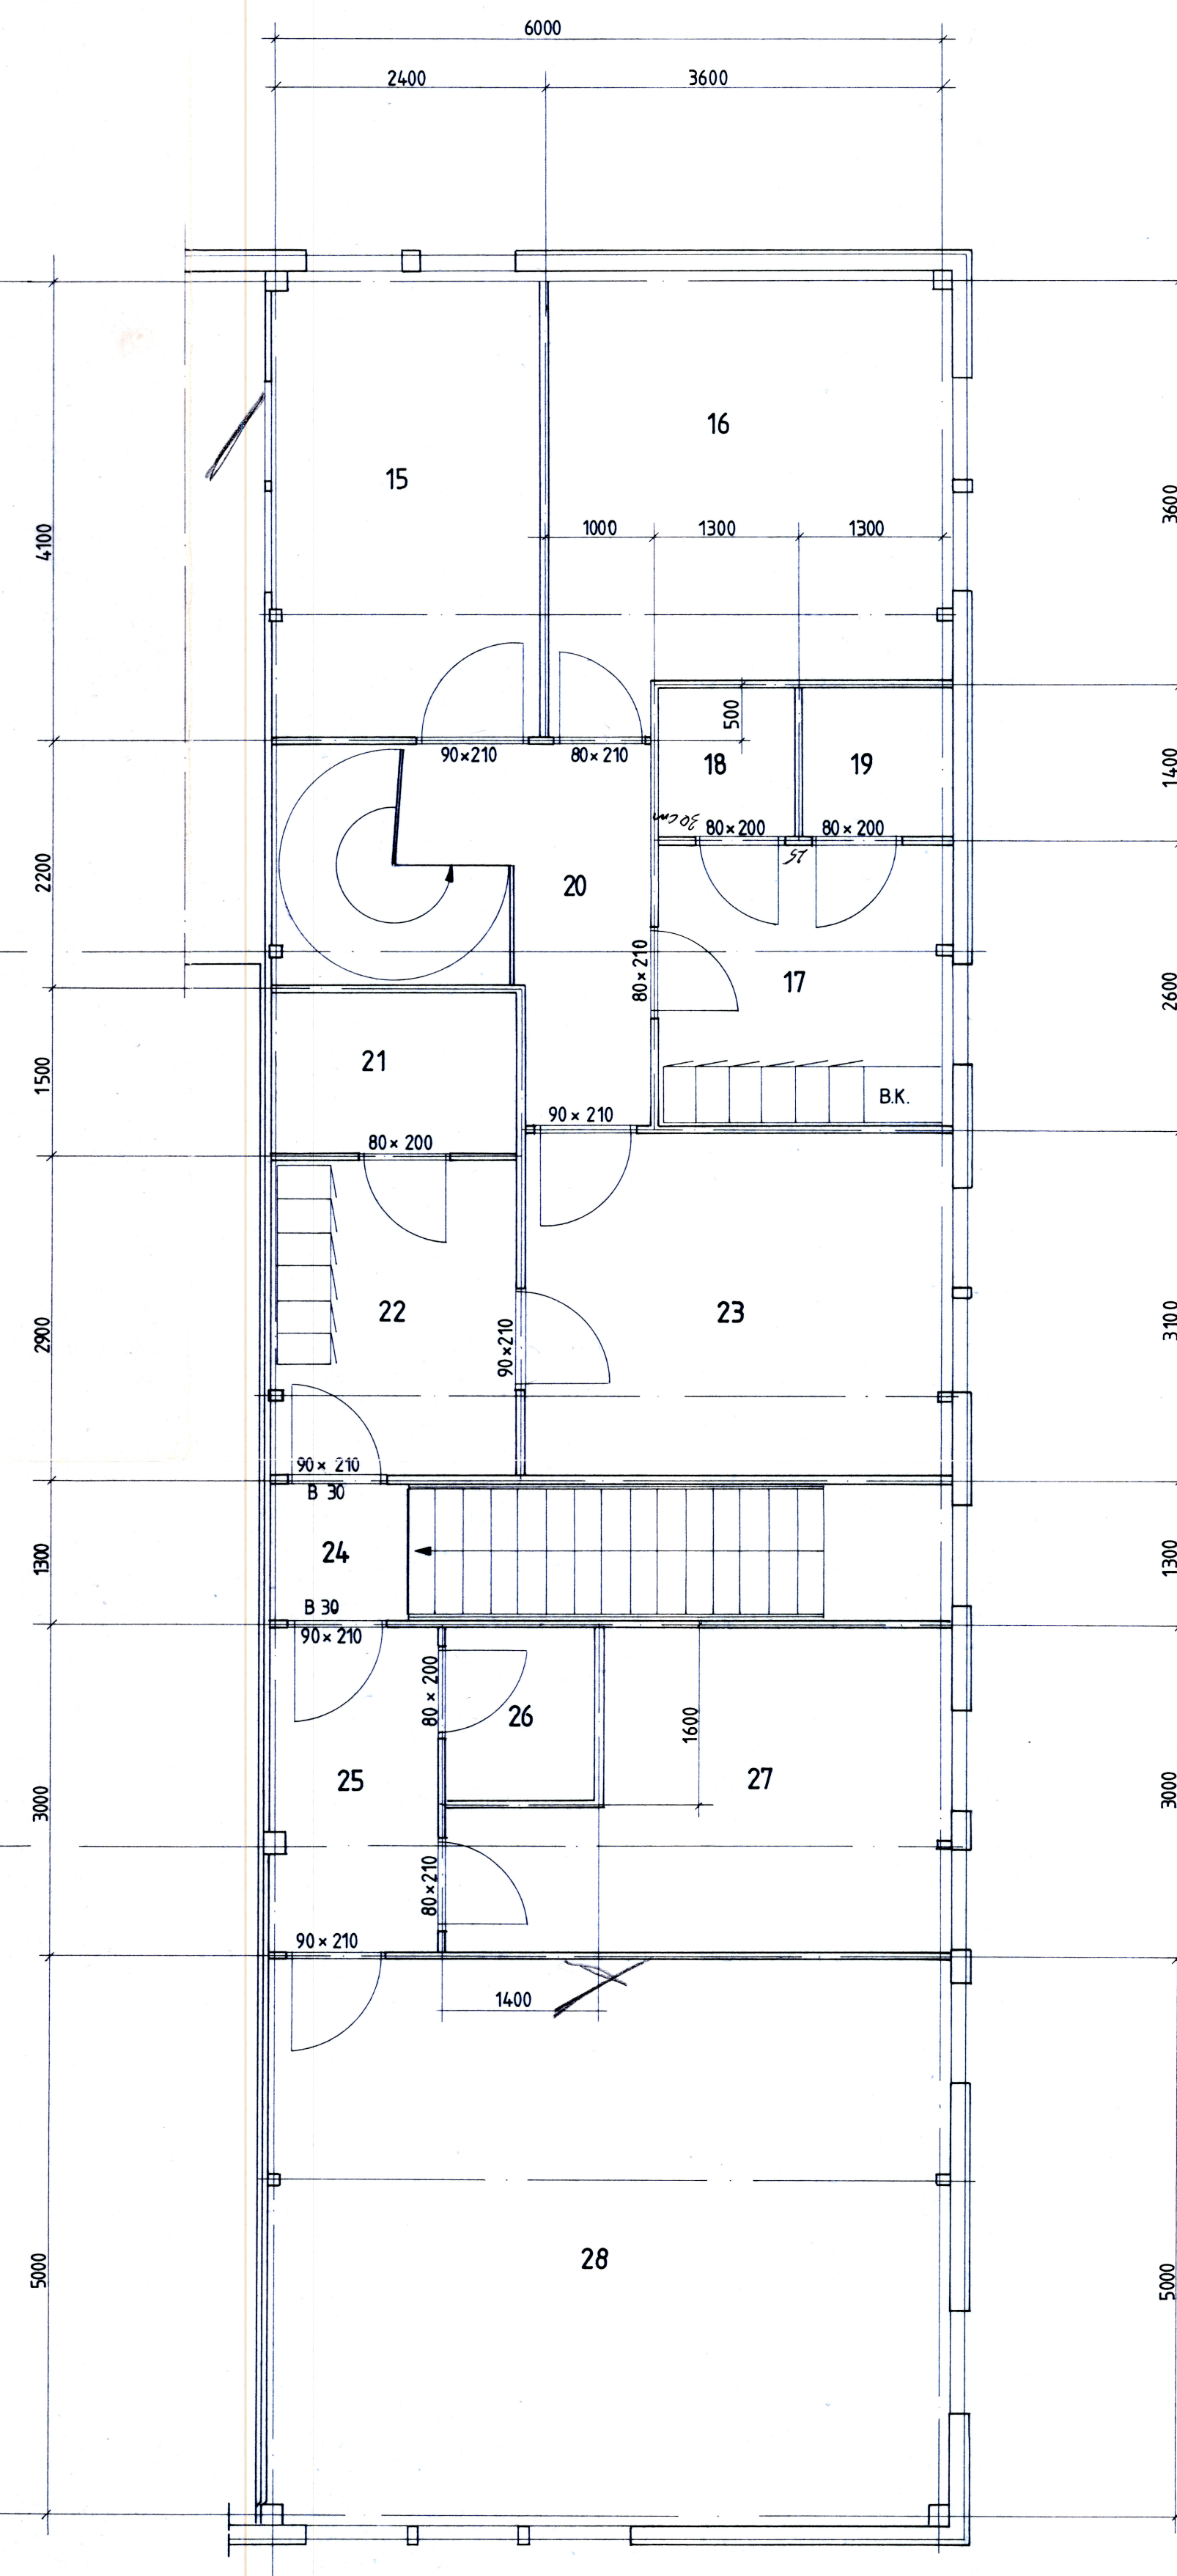

PLAN 2. ETG. (M 1:50)

REV.	REVISJONEN GJELDER	DATO	SIGN.
VARDØ HAVNEVESEN Nytt trafikkhavneanlegg		TEGN. 13.05.81	KGB
PLANTEGNING KONTORDEL		KNTR.	
		SAKSBEHANDLER:	KNUT G. BREIVIK
		M 1:50	
BARLINDHAUG A/S		SAK NR.	TEGN. NR.
Tlf. 085/51617 - Postboks 353 - 9801 Vadsø		623	17