


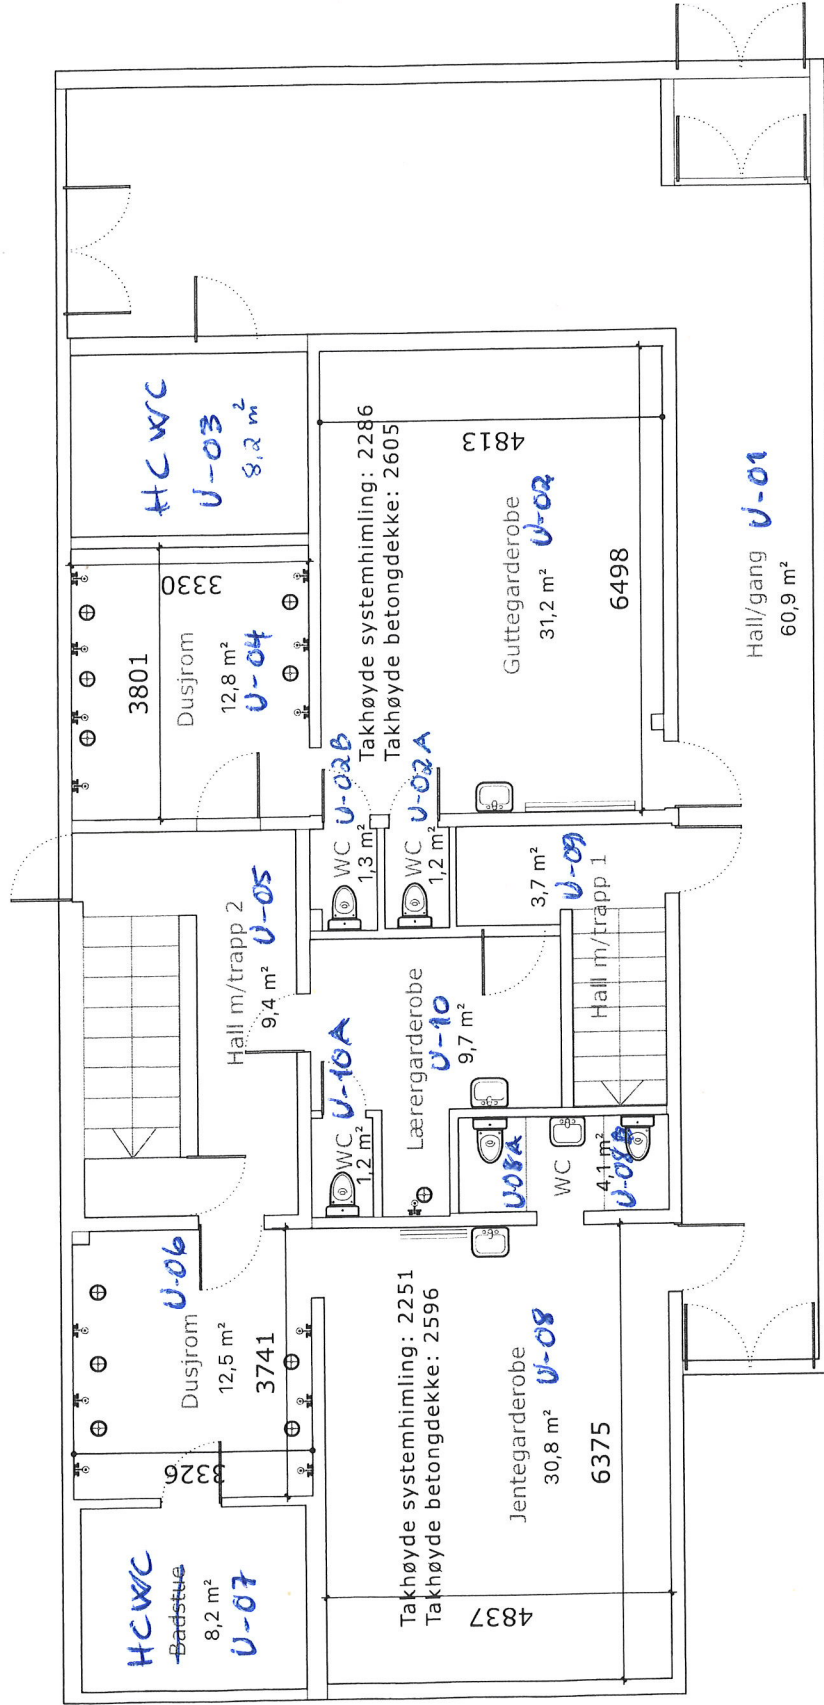

Planskisse Garderobeanlegg

scale: 1:100

A
01

23/6-26
0742