


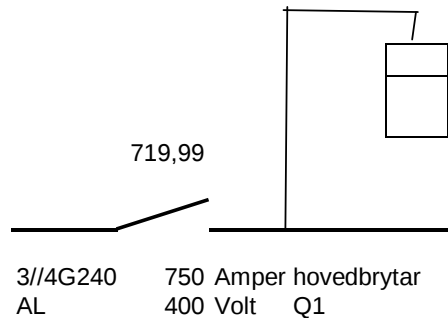

Kurs No :	Brytar/ Vern :	Forbrukar :	Effekt:	Amper	Kabel:	Kommentarer :
Q2	600A	Elektrokjel	400	580	2//4G240AL	
Q3	180A	Varmepumpe	80	115	4G95AL	
F4	C32A	VVB no 1	15	22	4G2,5CU	
F5	C32A	VVB no 2	15	22	4G2,5CU	
F6	C32A	VVB no 3	15	22	4G2,5CU	
F7	C32A	Varmtvannspumpe	8,5	15	4G2,5CU	
F8	C50A	Pumpesystem vanboren varme	25	45	4G25AL	
F9	C50A	Bassengfordeling	32	17,7	5G16 CU	
F10	C50A	Reserve				
F11	C16A	Lys og stikk teknisk rom			3G2,5CU	
F12	C16A	Stikk VVB			3G2,5CU	
F13	C16A	Vifte			3G2,5CU	
F14	C16A	Reserve				
F15	C16A	Reserve				
		Sum	590,5	800		

Samt. Faktor:
0,75

Einlinjeskjema
Energitavle Varmesentral
Strandebarm Skule;idretshall
Tavlerom symjebasseng

Tegn.:	Rolf
Dato:	16.05.2008
Rev.:	B/18.03.2009
N0:	2008.100

**HOVLAND
ELEKTRO**
Postboks 245 5408 Sagvåg