


Dører


- ① E130Sa
- ② E130CSa

— E130
remningsvei
→ ramming

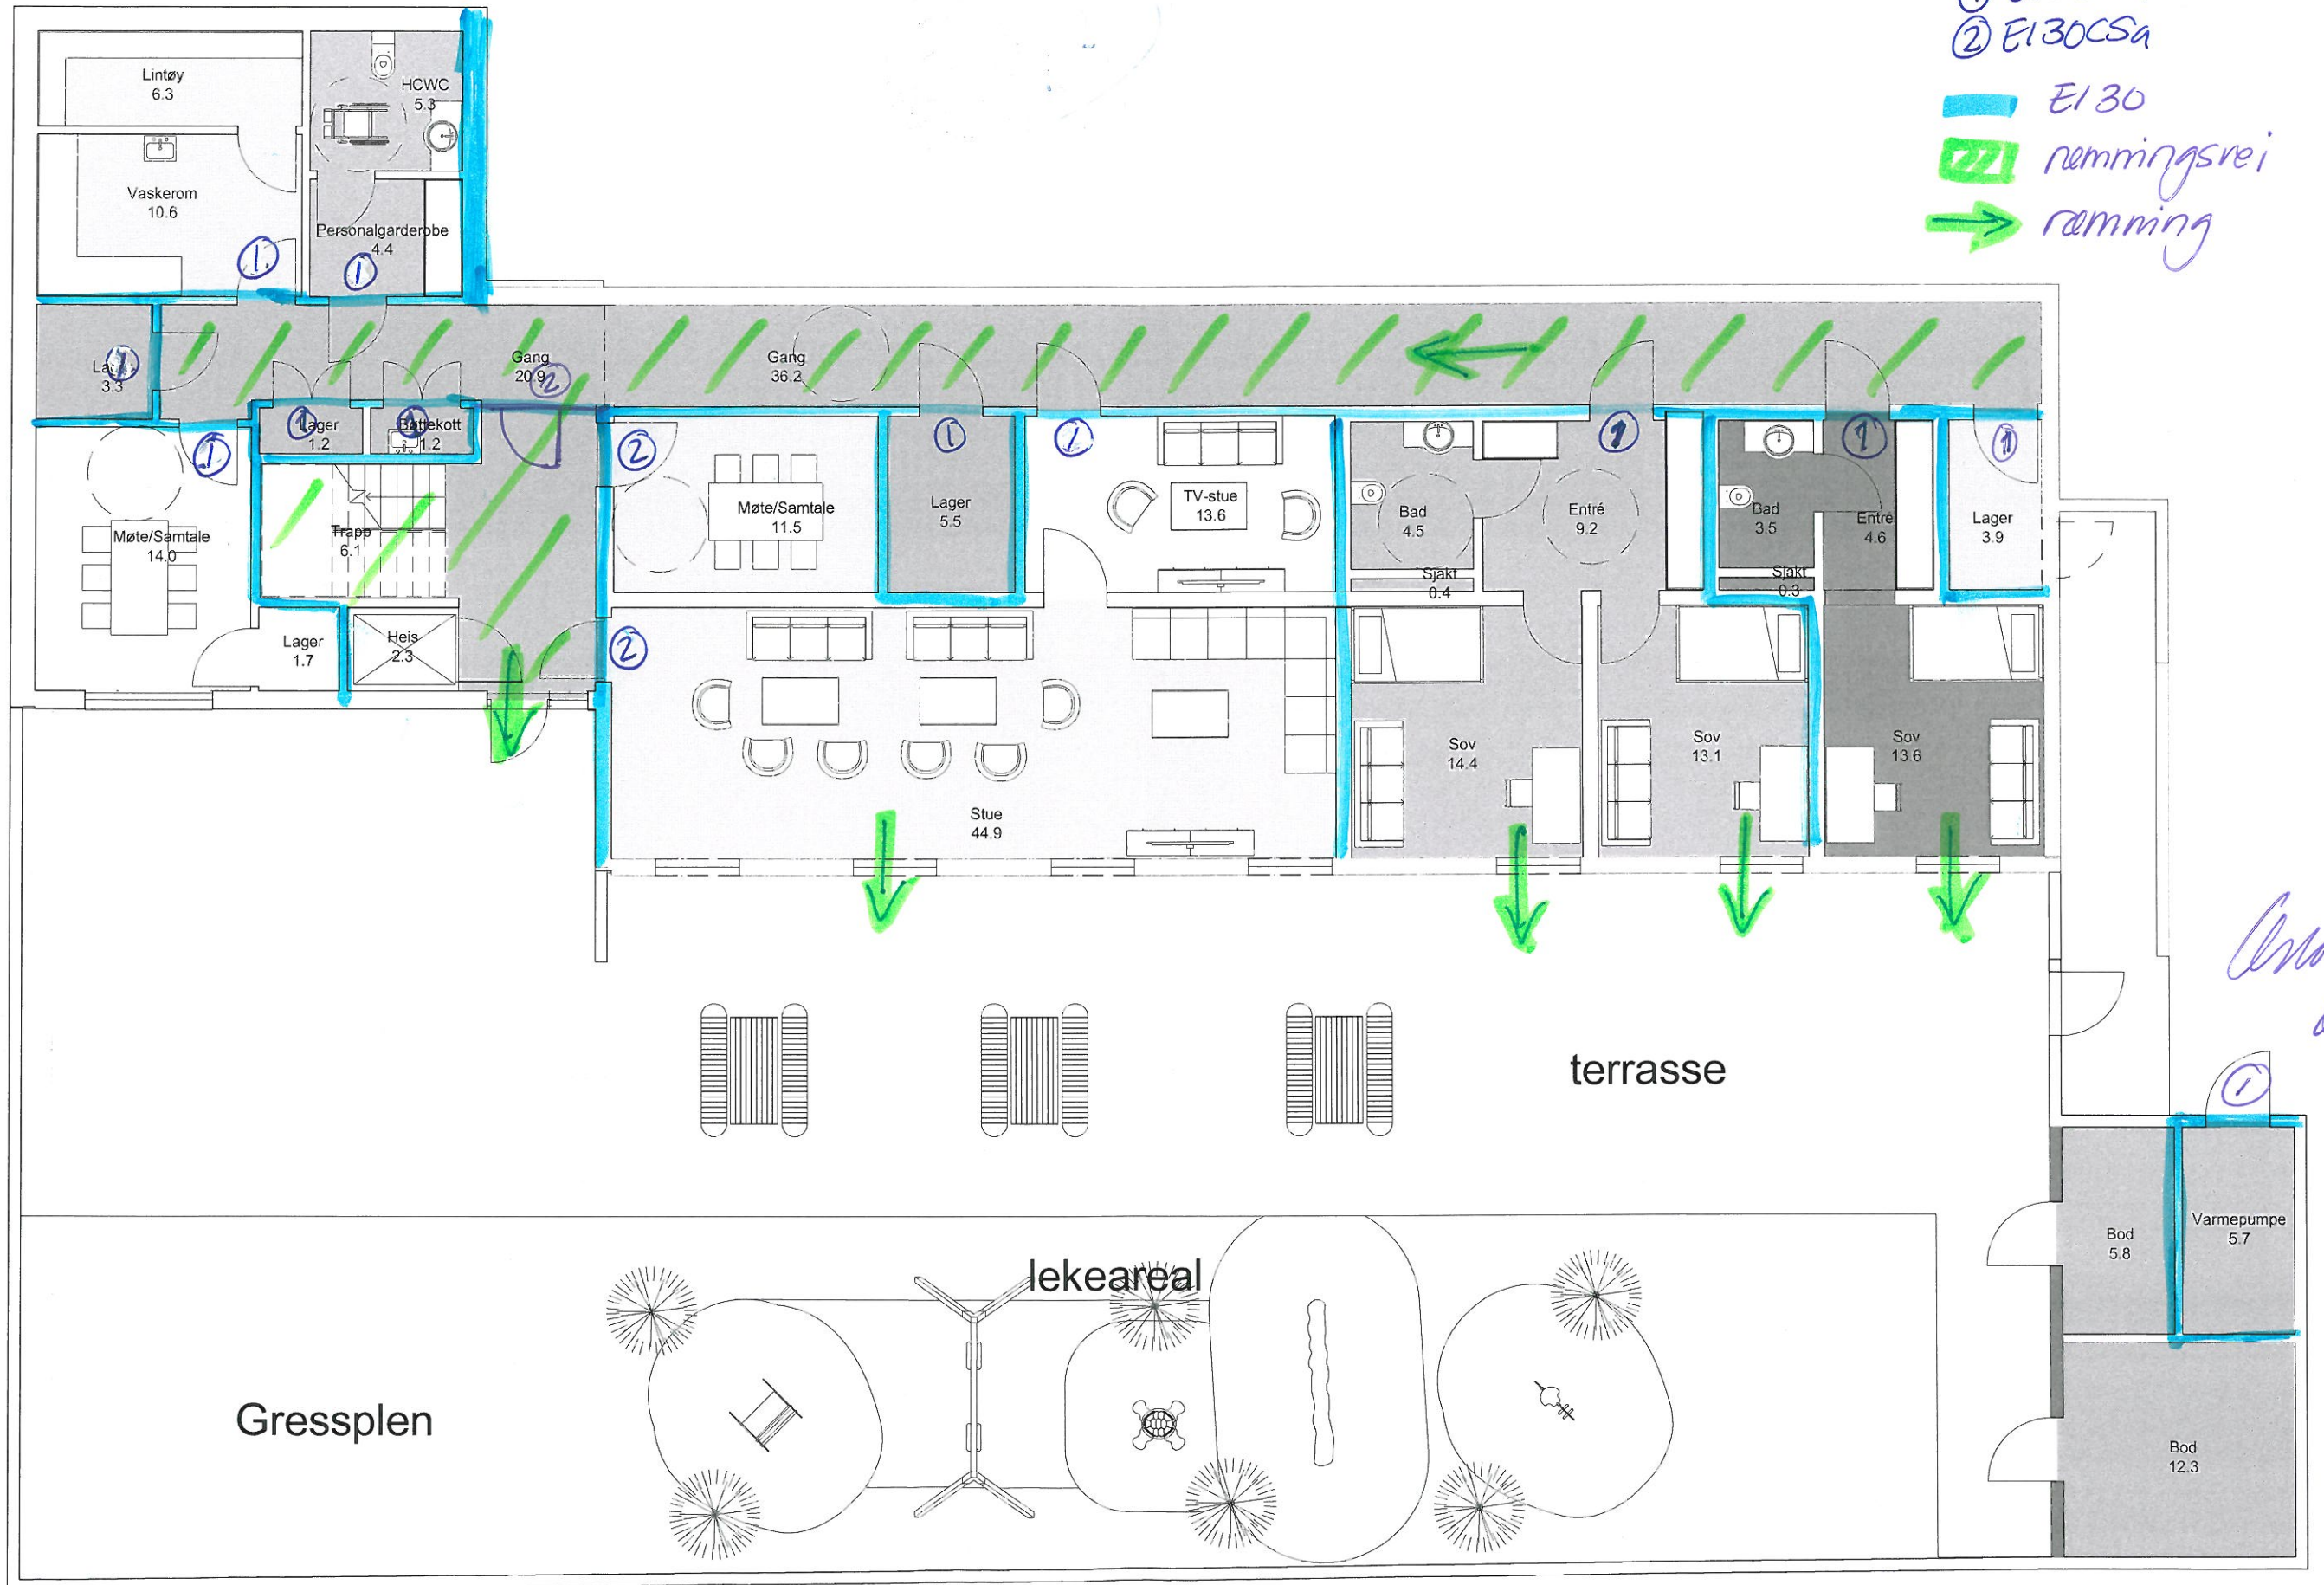

Ansatt 22.10.15
AG.

rommingsvindu

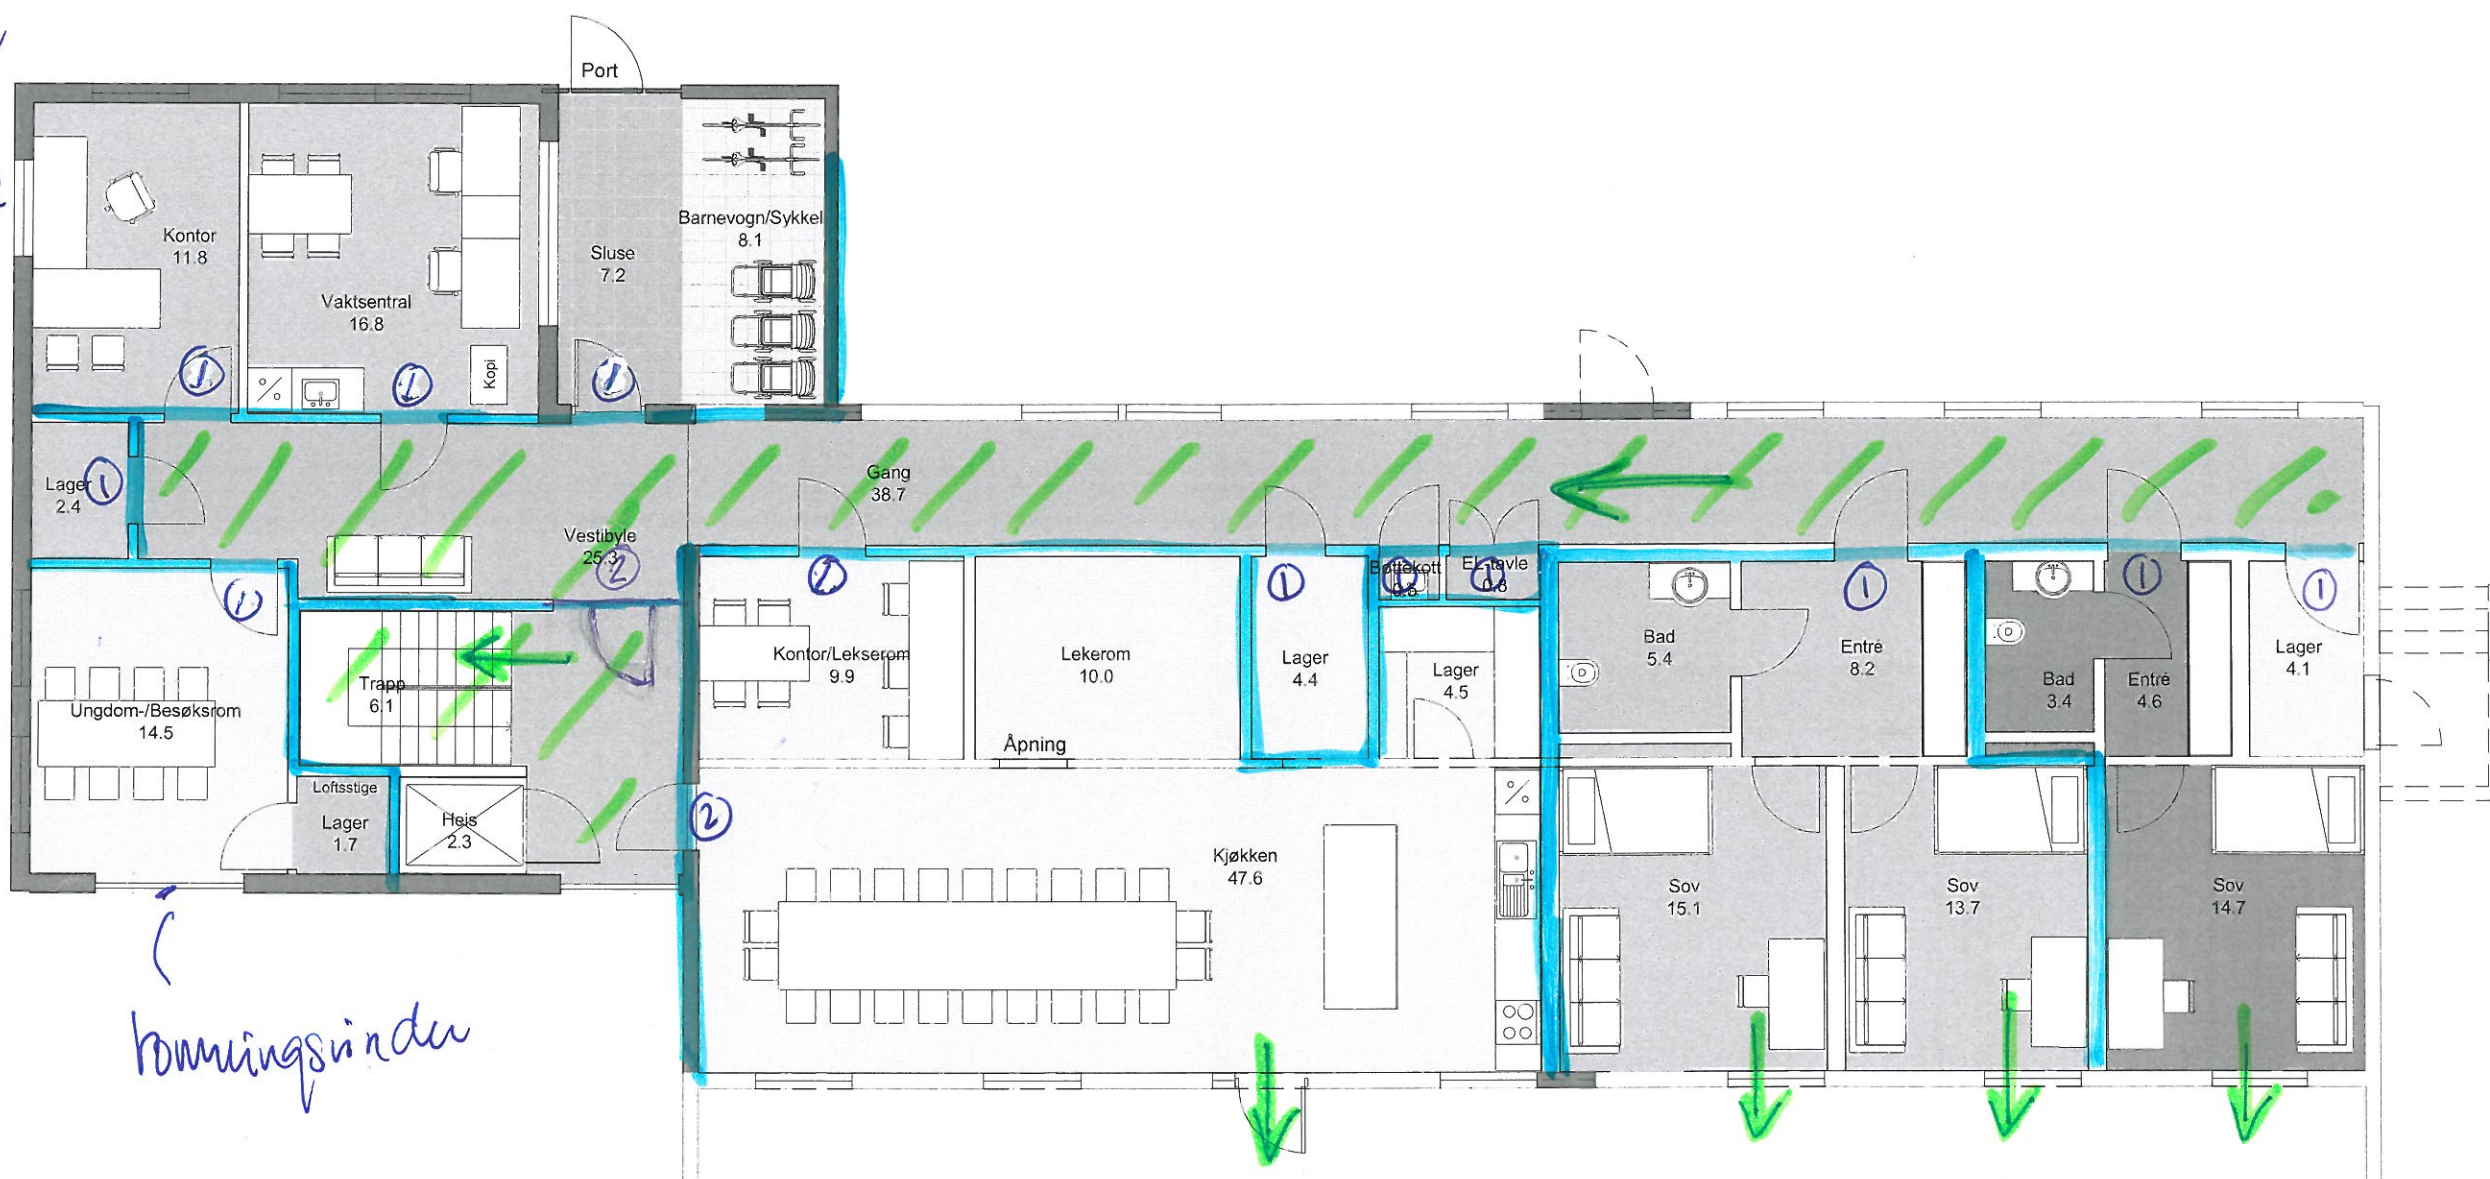

rommingsvindu

Mo 22.10.15
PA