




- Endel forandringer
på tegningene
14/2-86
M. Hansen

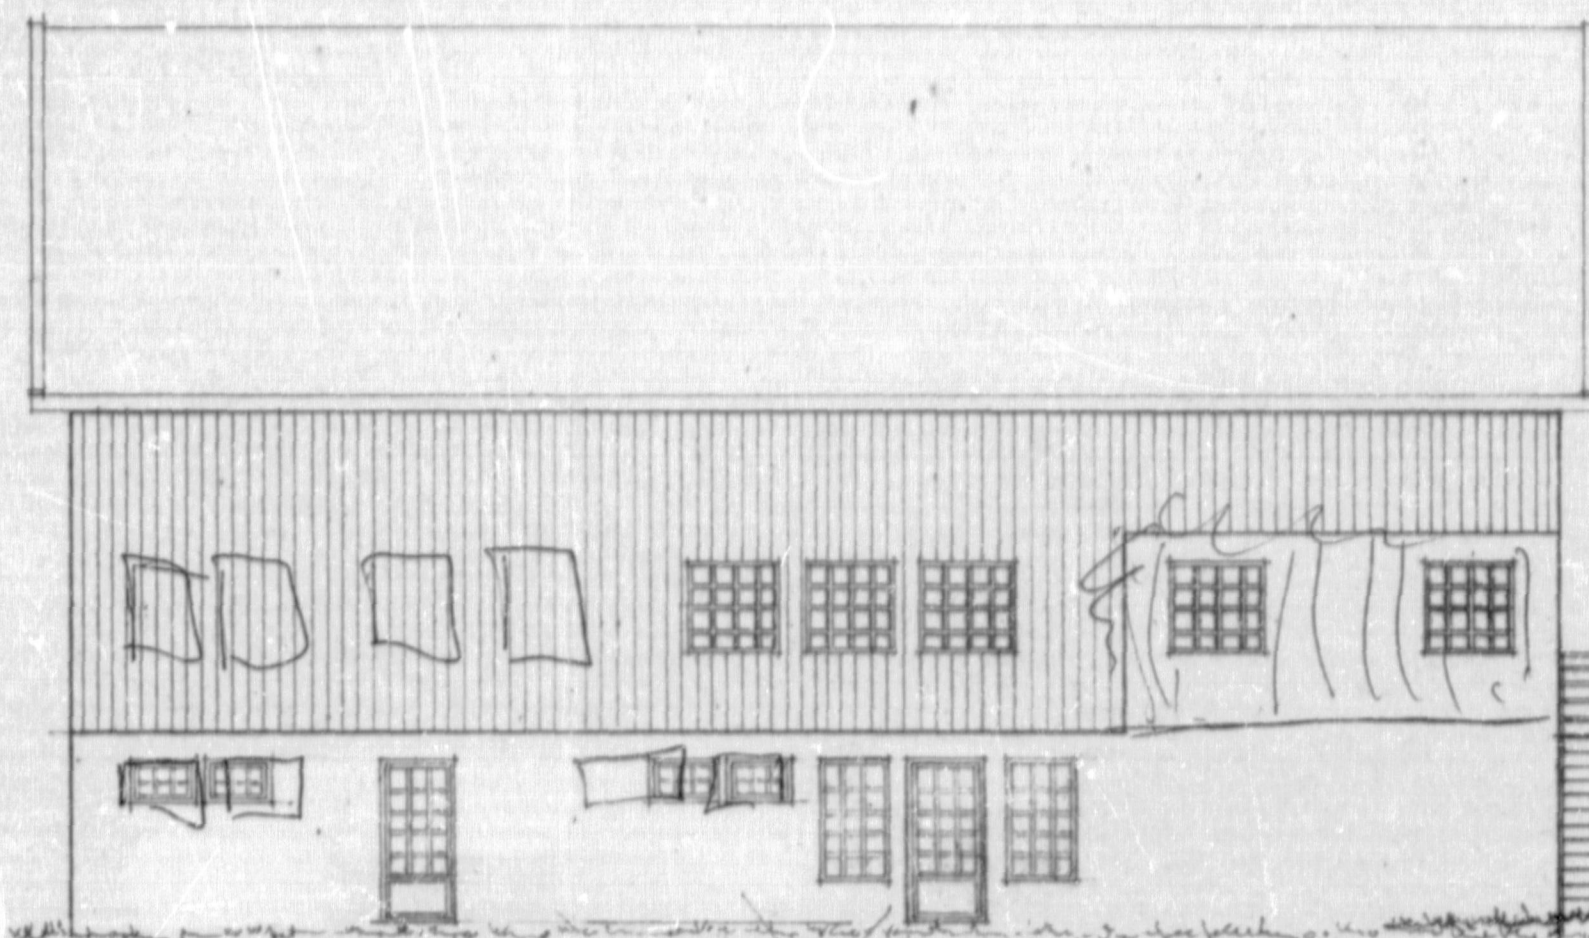


FASADE A

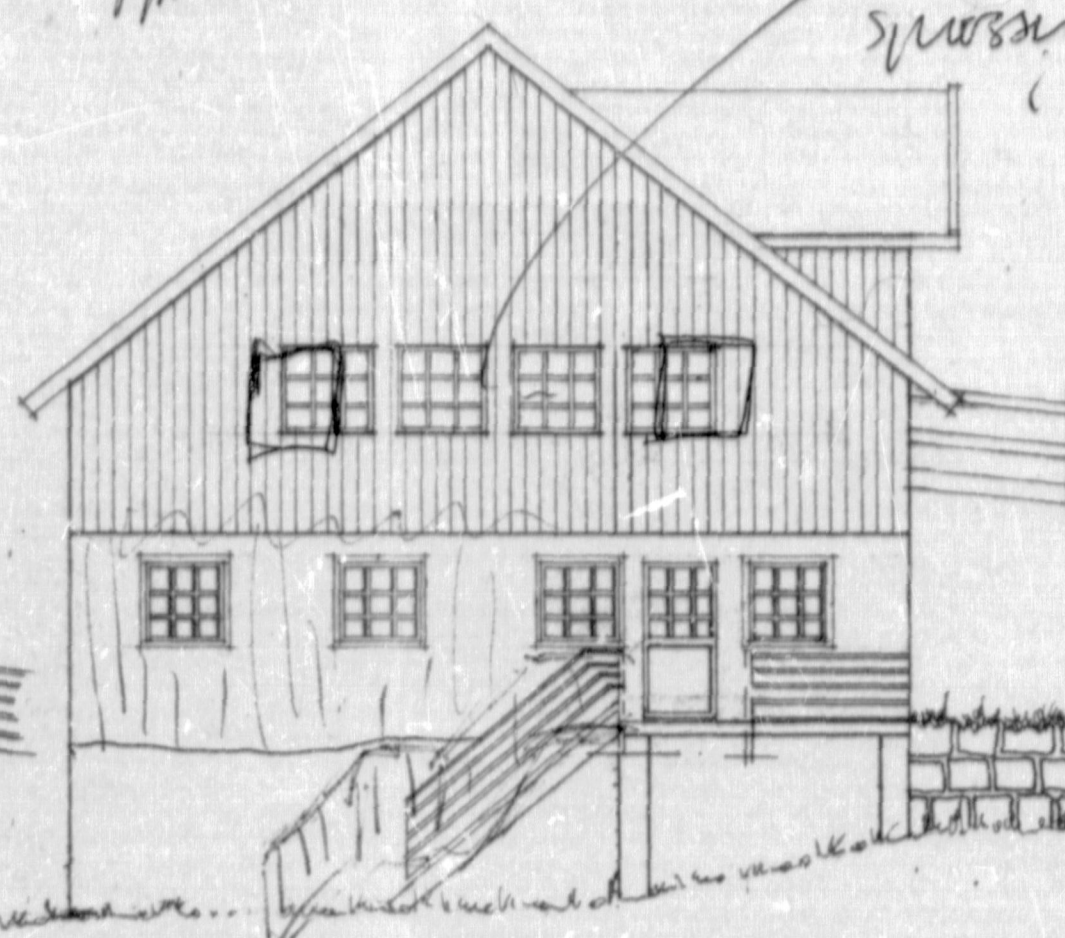


FASADE B

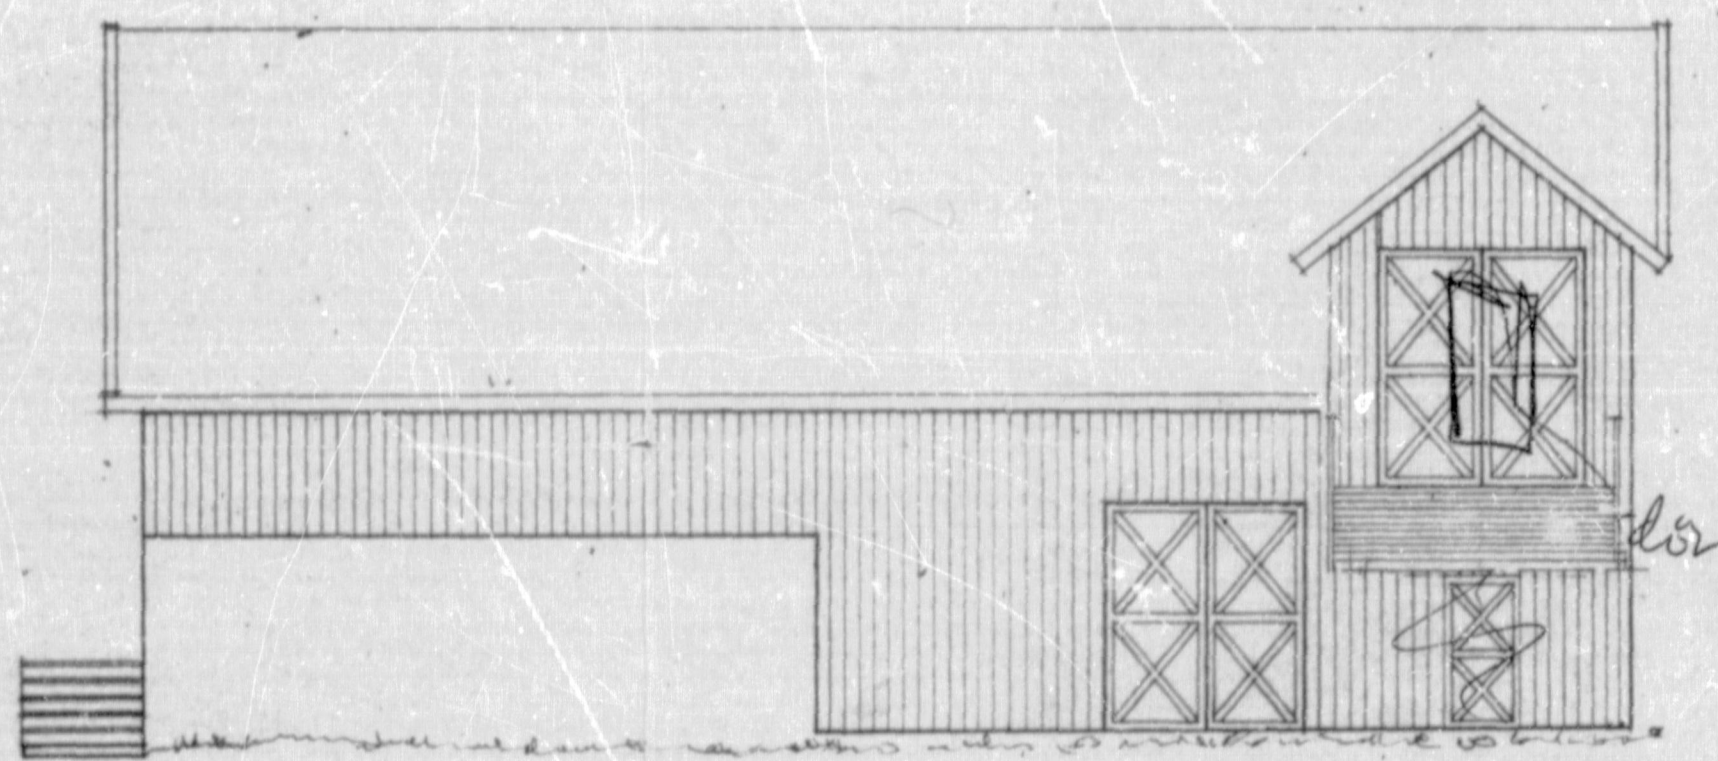



FASADE C

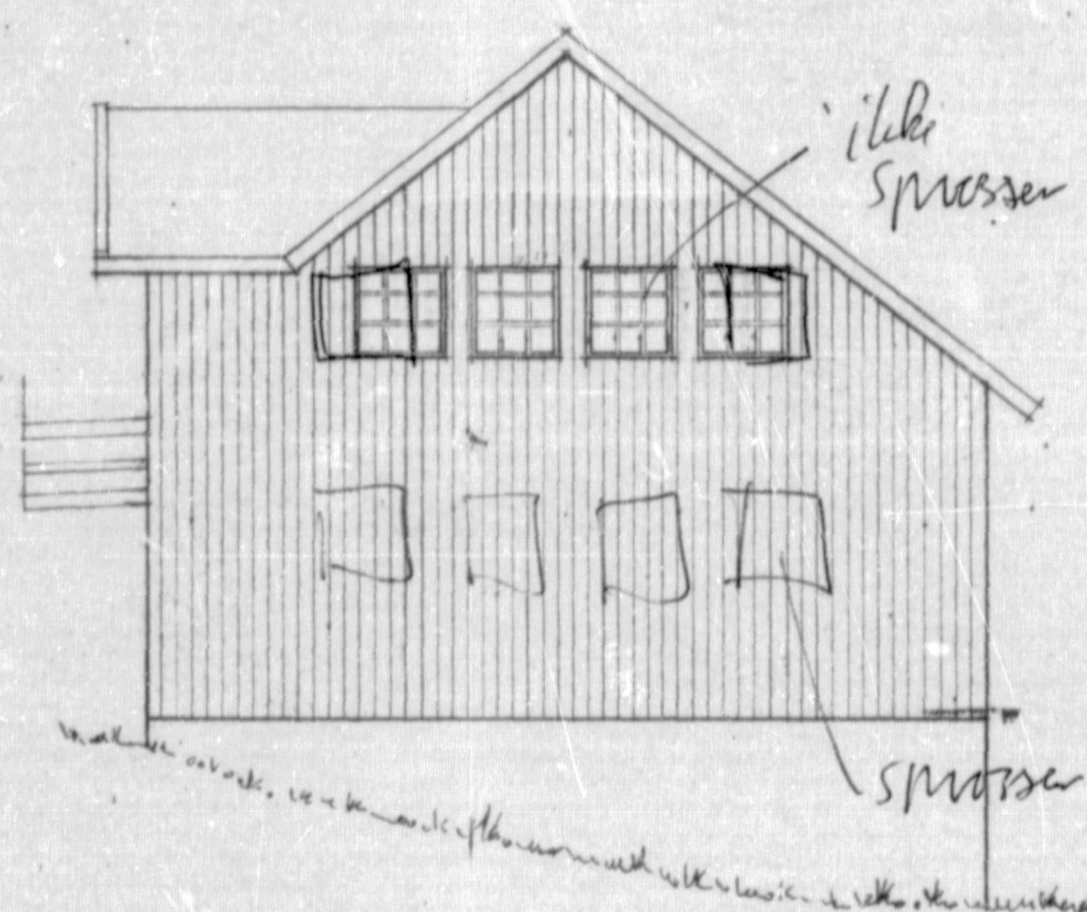


FASADE D

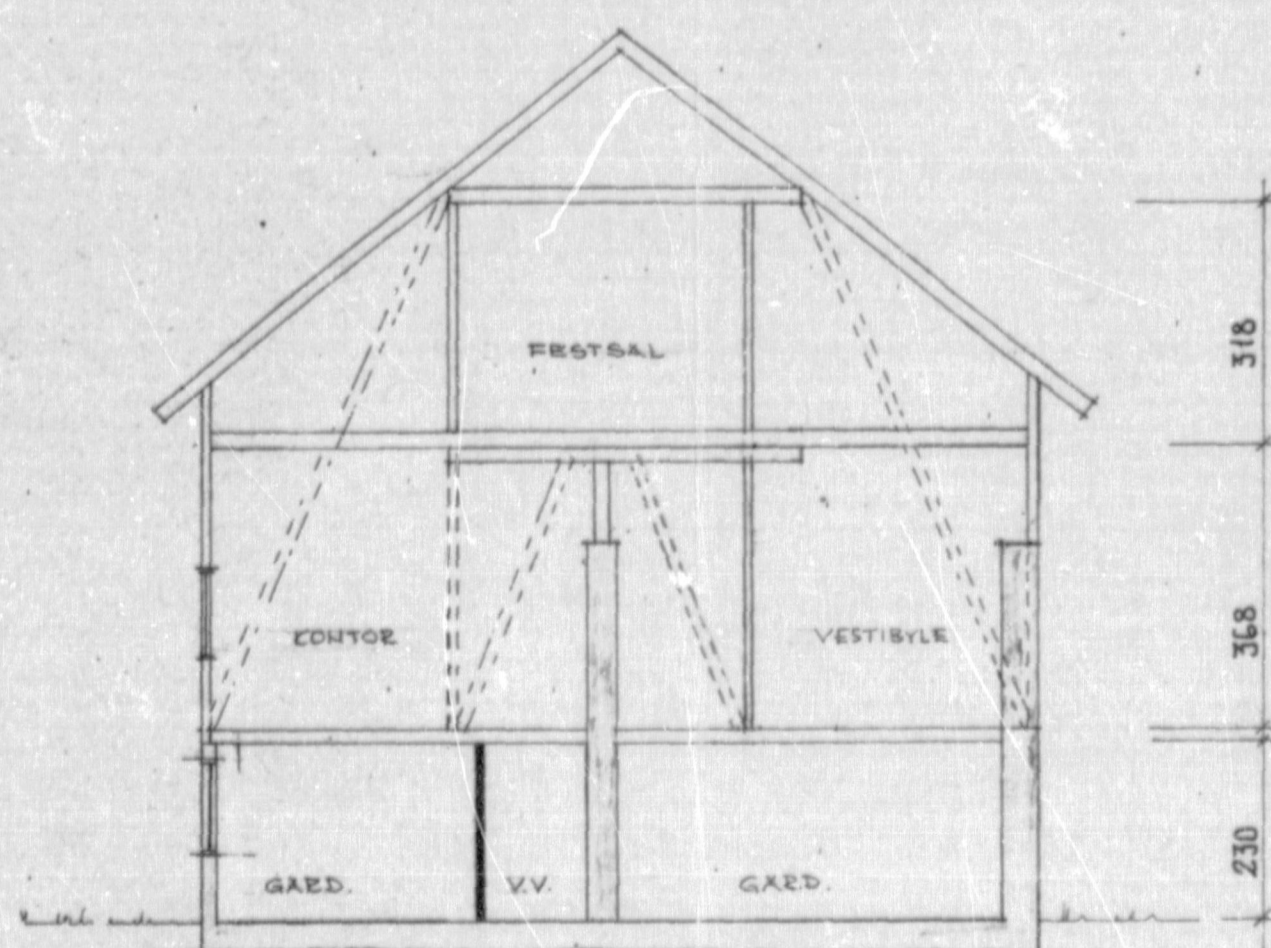


SNITT A-A

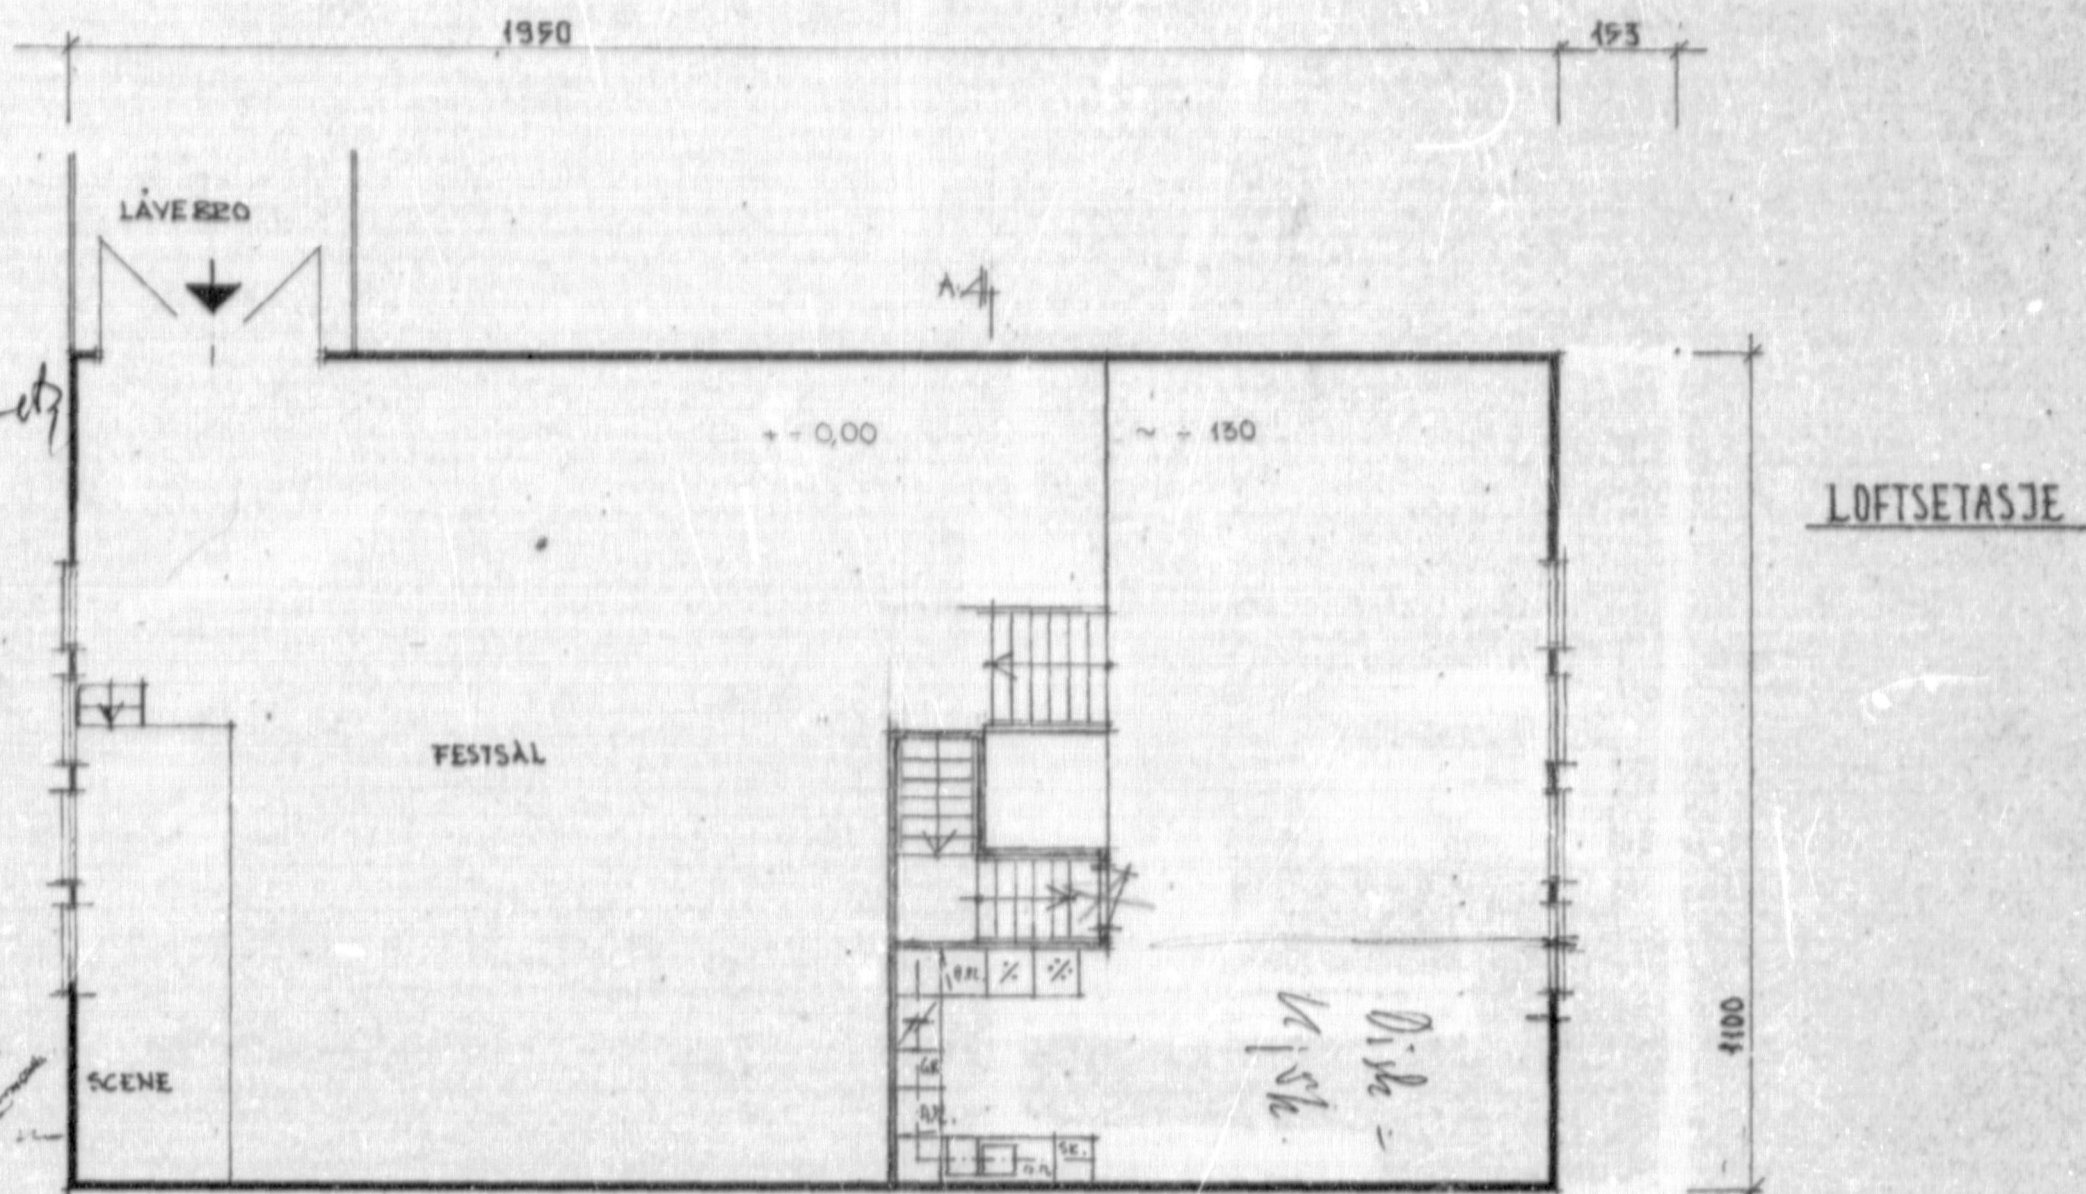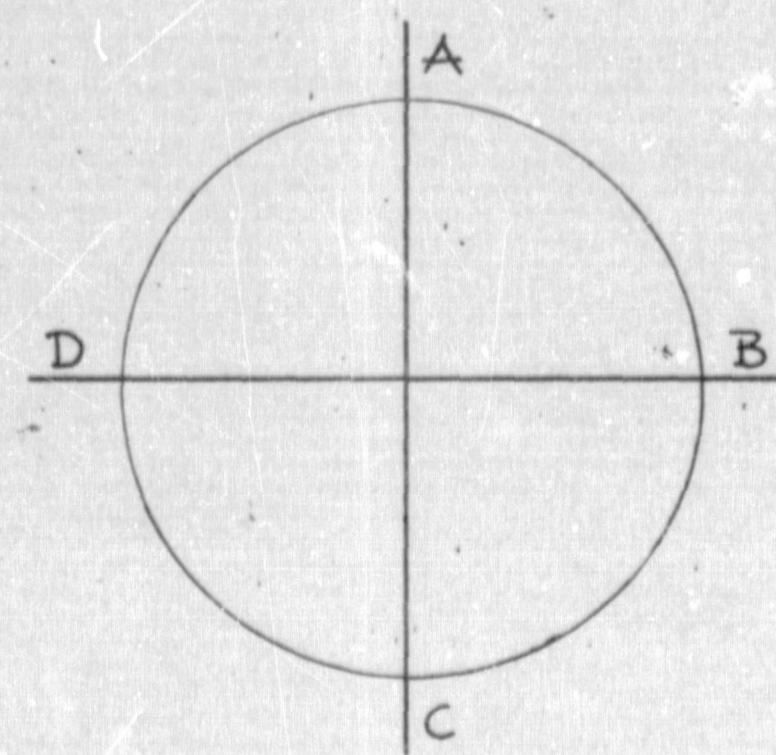

LOFTSETASJE

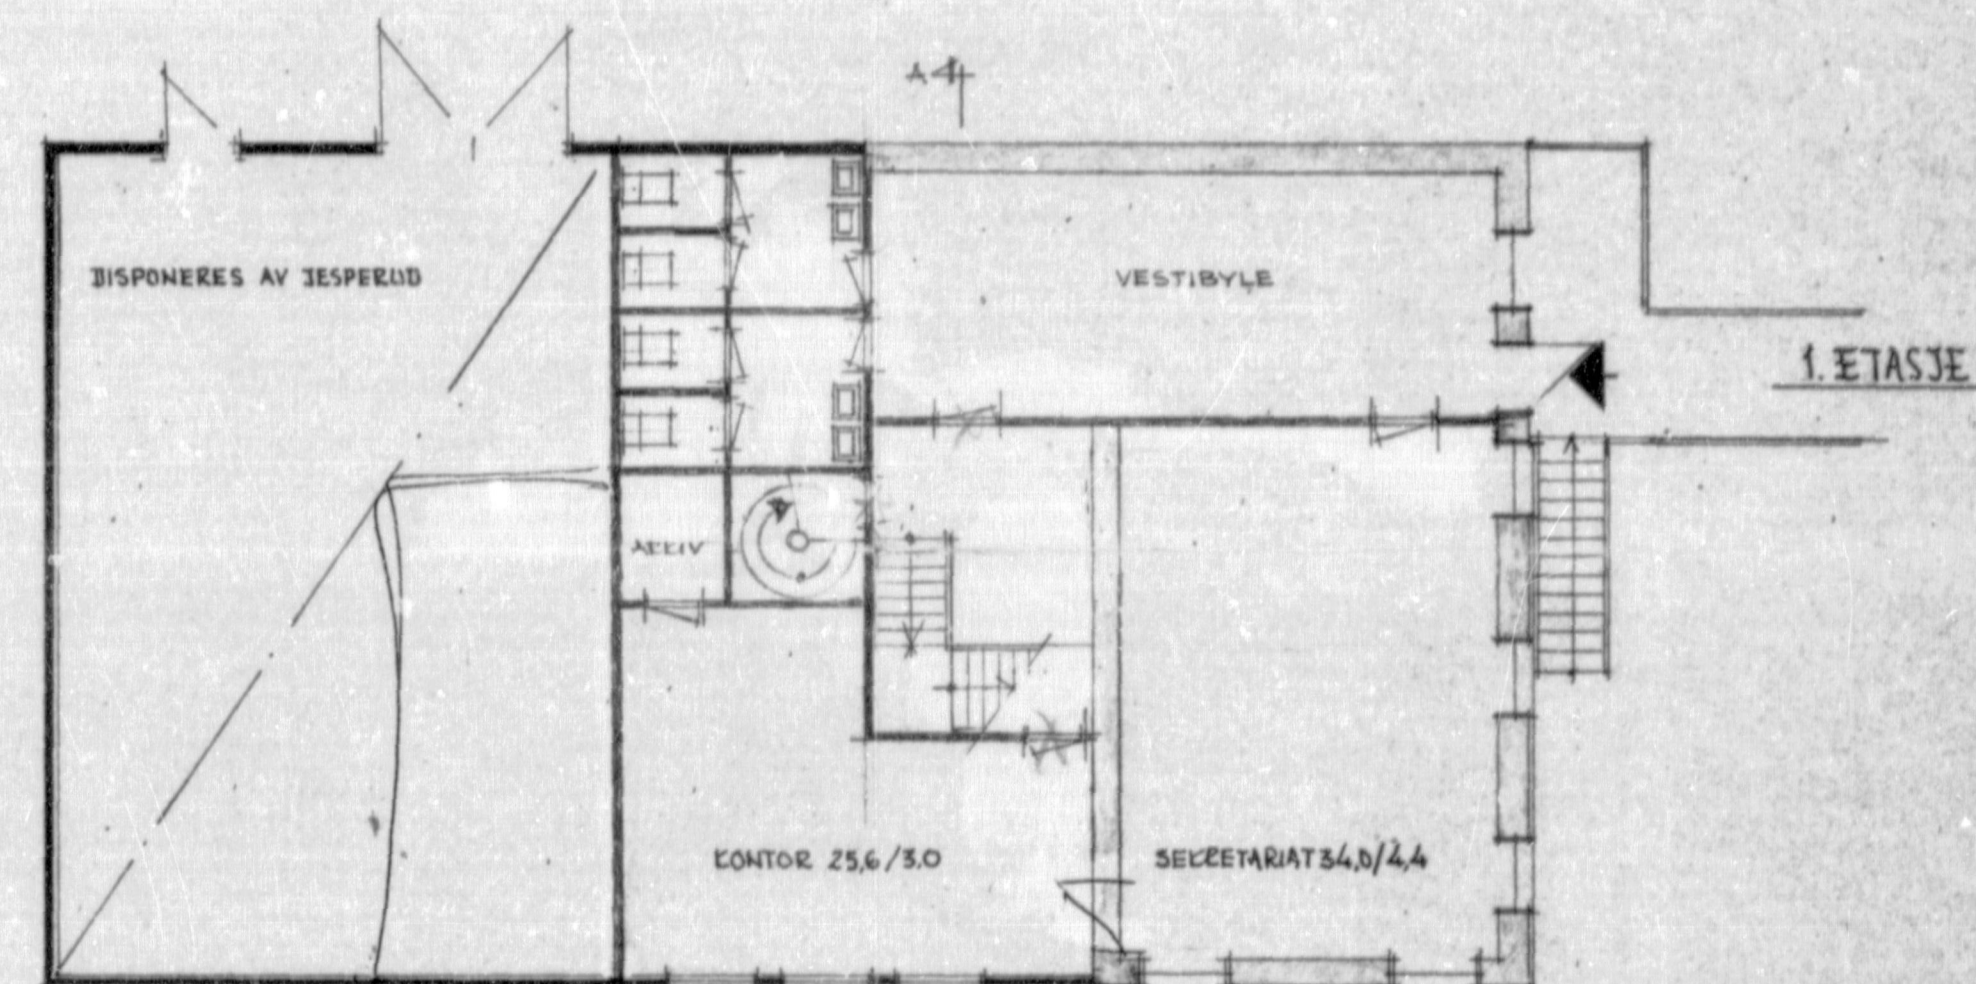

1. ETASJE

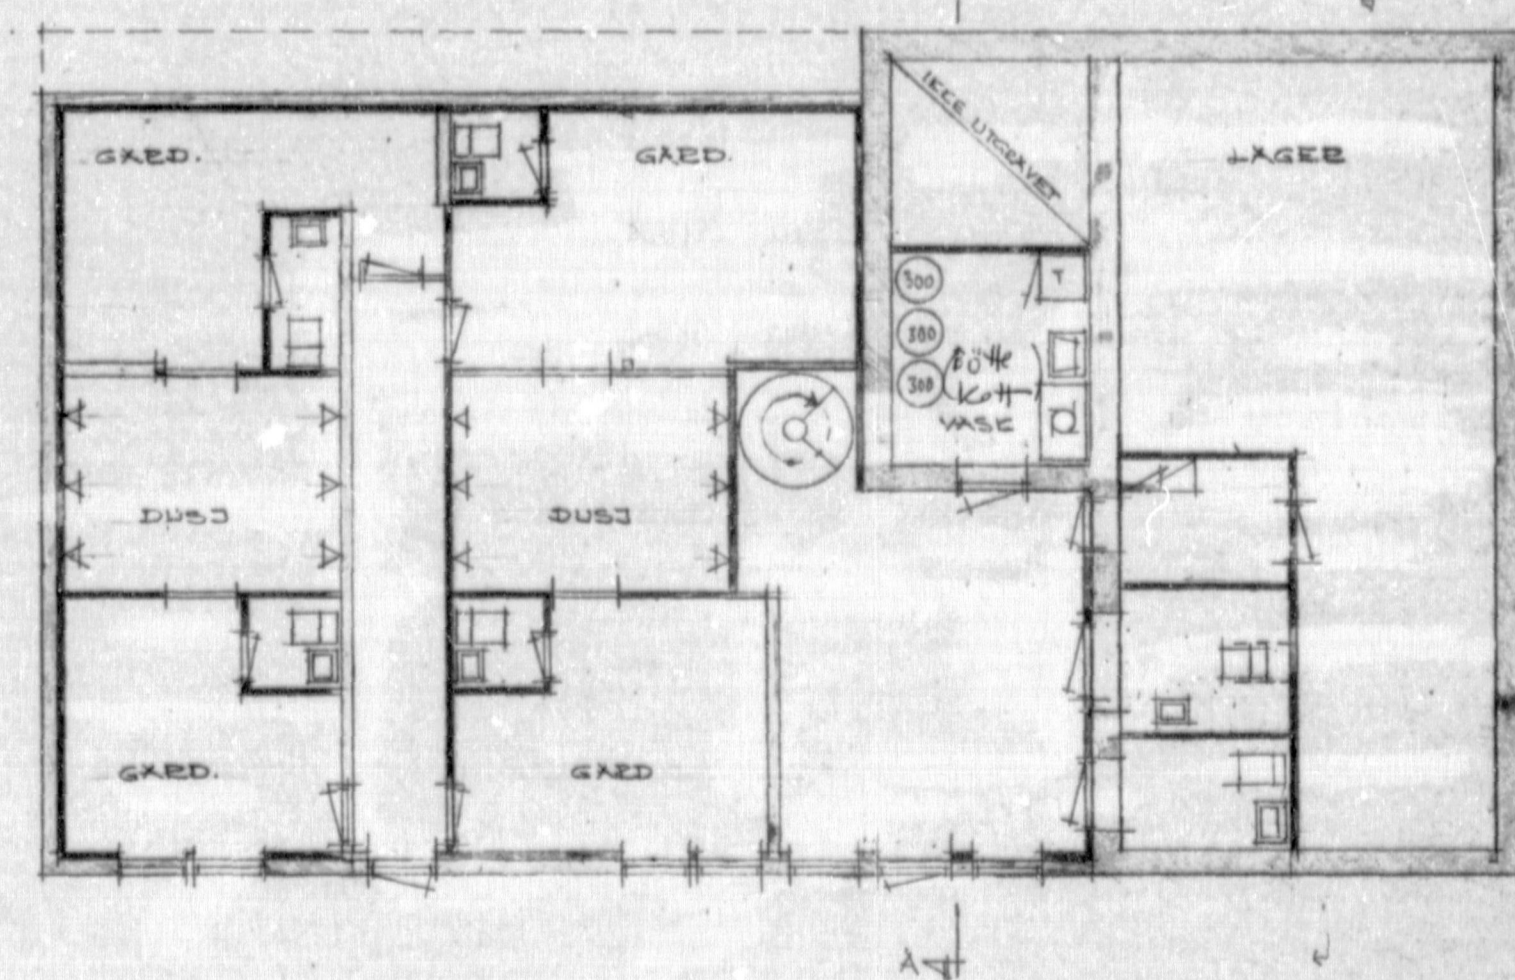

KJELLERETASJE

OSLO BYGNINGSKONTROLL
MOTTATT
20.07.1980

2

E	28.9.81	NYTEGN K1, 1. ET, 2. ET, HALL, T.F.
D	17.11.79	NYTEGN 1. ET, LOFTSET - 3.07.79, 1. ET
C	15.10.78	TEGN. INN OG UT. TRAPP
B	25.4.78	DUST-GARD-VEI - RAMPE 1. ET, 1. ET
A	26.10.77	ENDRET DUST OG GARD
REV	0.10	REV. OMFATTER
		REV. AV KONTE

PROSJEKT	KLUBBHUSET VESTLI I.L.		
FELT	JESPERUD	GARD NR.	100
		BRUKS NR.	38
TEGNING OMFATTER	PLANER OG FASADER		
MAK	1:100	DATO	19.10.76
		TEGNET AV	M. Hansen
		KONTROLL	
TEGN. NR.		PROSJEKT NR.	GRUPPE
		HUSNR.	NR.
		REV.	2. E

TEGNINGENE ER
NEDFOTOGRAFERT - 21 X