



FAUSKE HELSETUN SYSTEM 36.03

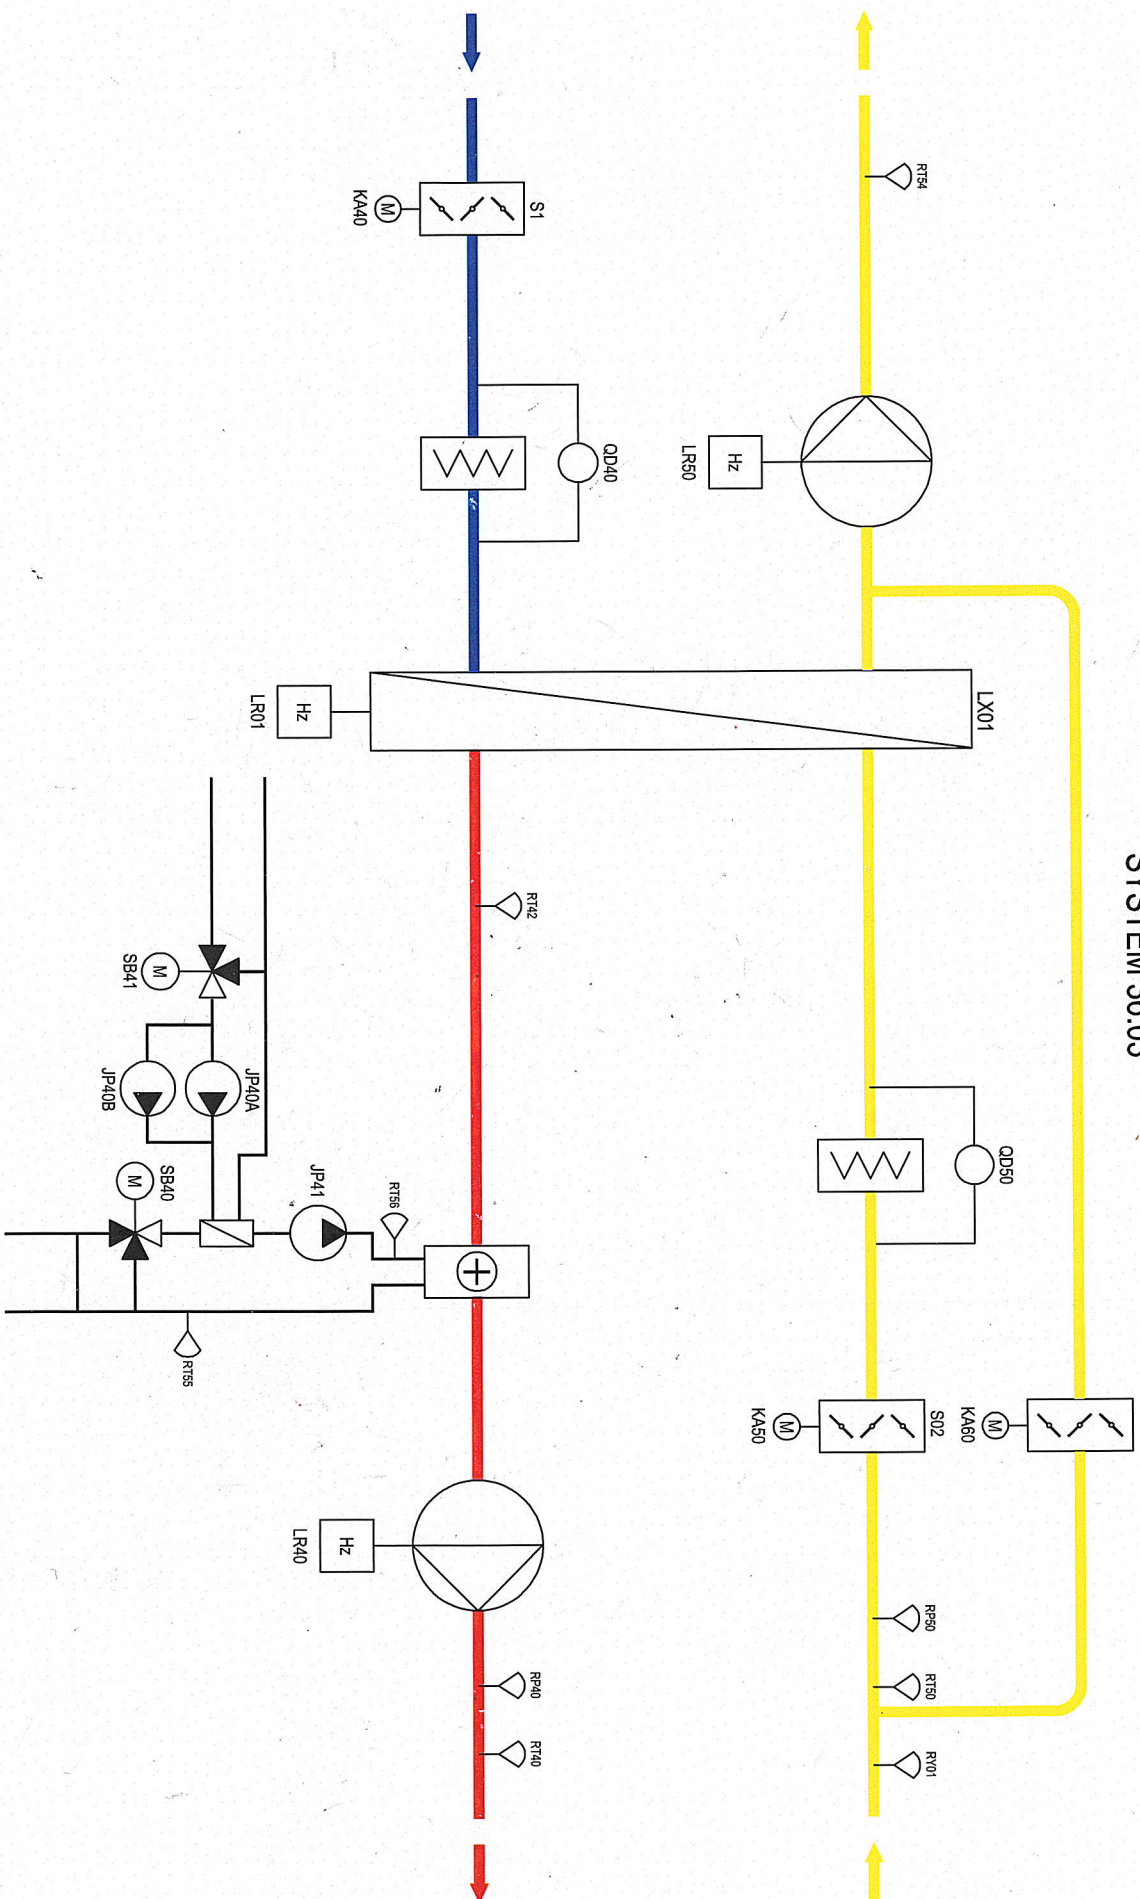

B	Skema endret	SKO	05.04.06
A	Som bygd	SKO	07.12.05
NO.	REVISION	SIGN.	DATE

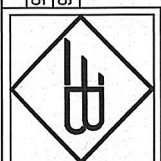

ELEKTRISK BYRÅ AS
TJELDBERG 4
8012 BODØ
TELEFON 75 58 60 30
FAX 75 58 60 31

FAUSKE HELSETUN
BYGG C
VENTILASJON 36.03
BLINDSKJEMA

JOB NUMBER	4680	DRAWING NUMBER	EB05-1131-02
DESIGNED BY	SKO	DRAWN BY	SKO
DATE	24.10.05	REV.	B
		SHEET	01
		CONT SHEET	02

FAUSKE HEISETUN
SYSTEM 36.04




JOB NUMBER		DRAWING NUMBER	
4680		EB05-1131-02	
DESIGNED BY		DRAWN BY	
SKO		SKO	
DATE		REV.	
24.10.05		B	

FAUSKE HEISETUN		BYGG C	
VENTILASJON 36.04		BLINDSKJEMA	

ELEKTRISK BYRÅ AS		TJELDBERGET 4	
8012 BODØ		TELEFON 75 58 60 30	
FAX 75 58 60 31			


NO.		SIGN.		DATE	
A		SKO		07.12.05	
B		SKO		05.04.06	

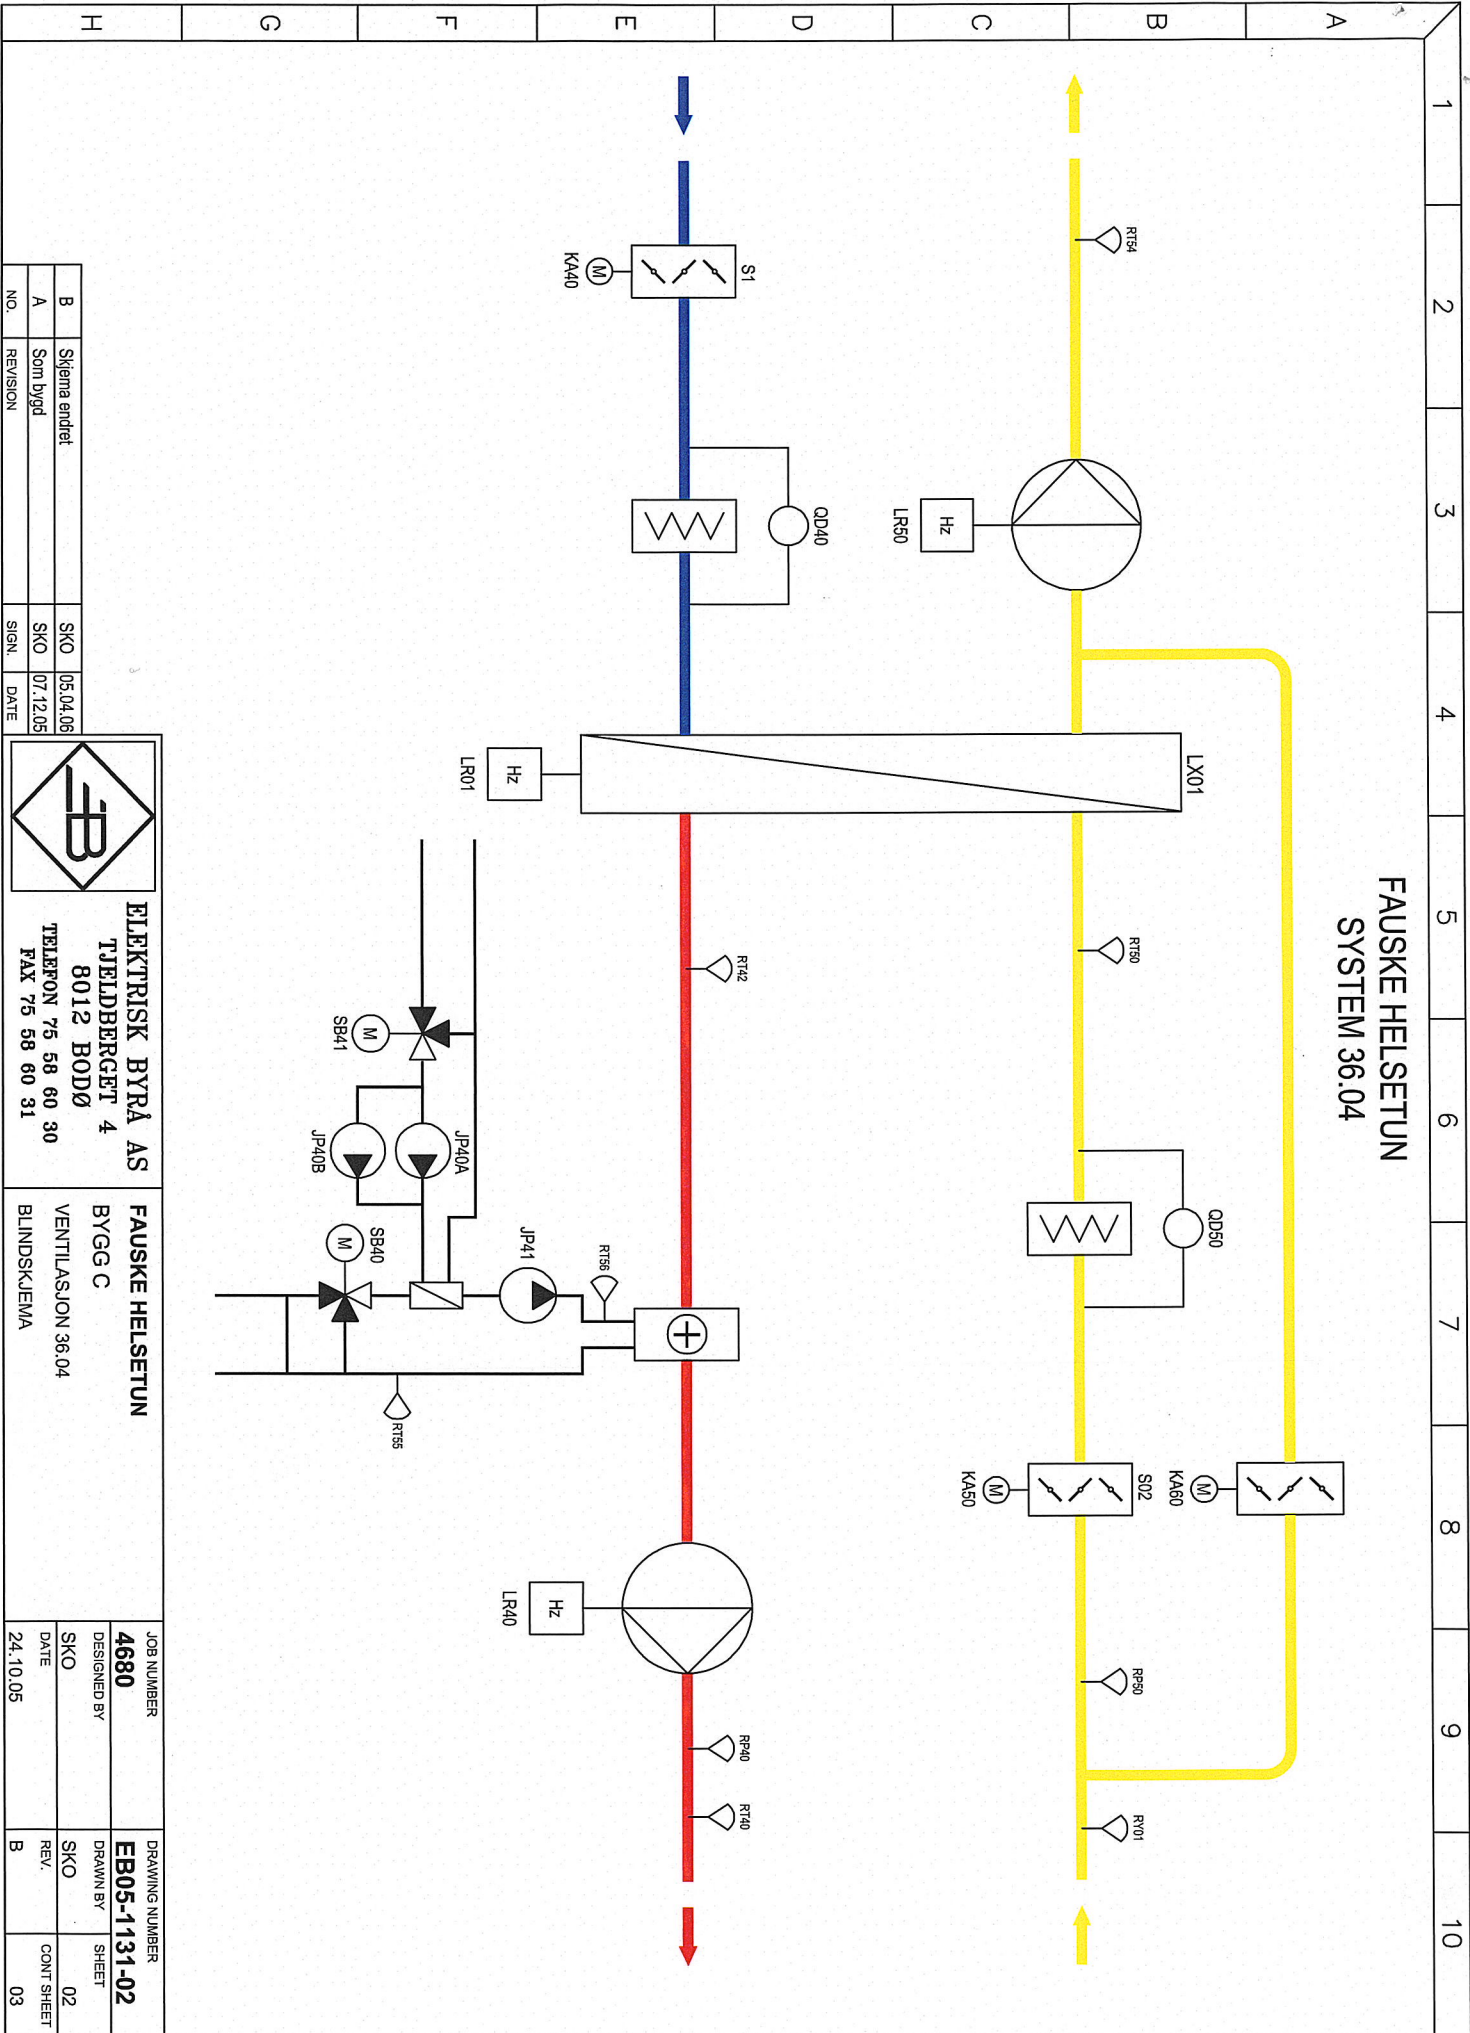

**FAUSKE HEISETUN
SYSTEM 36.04**



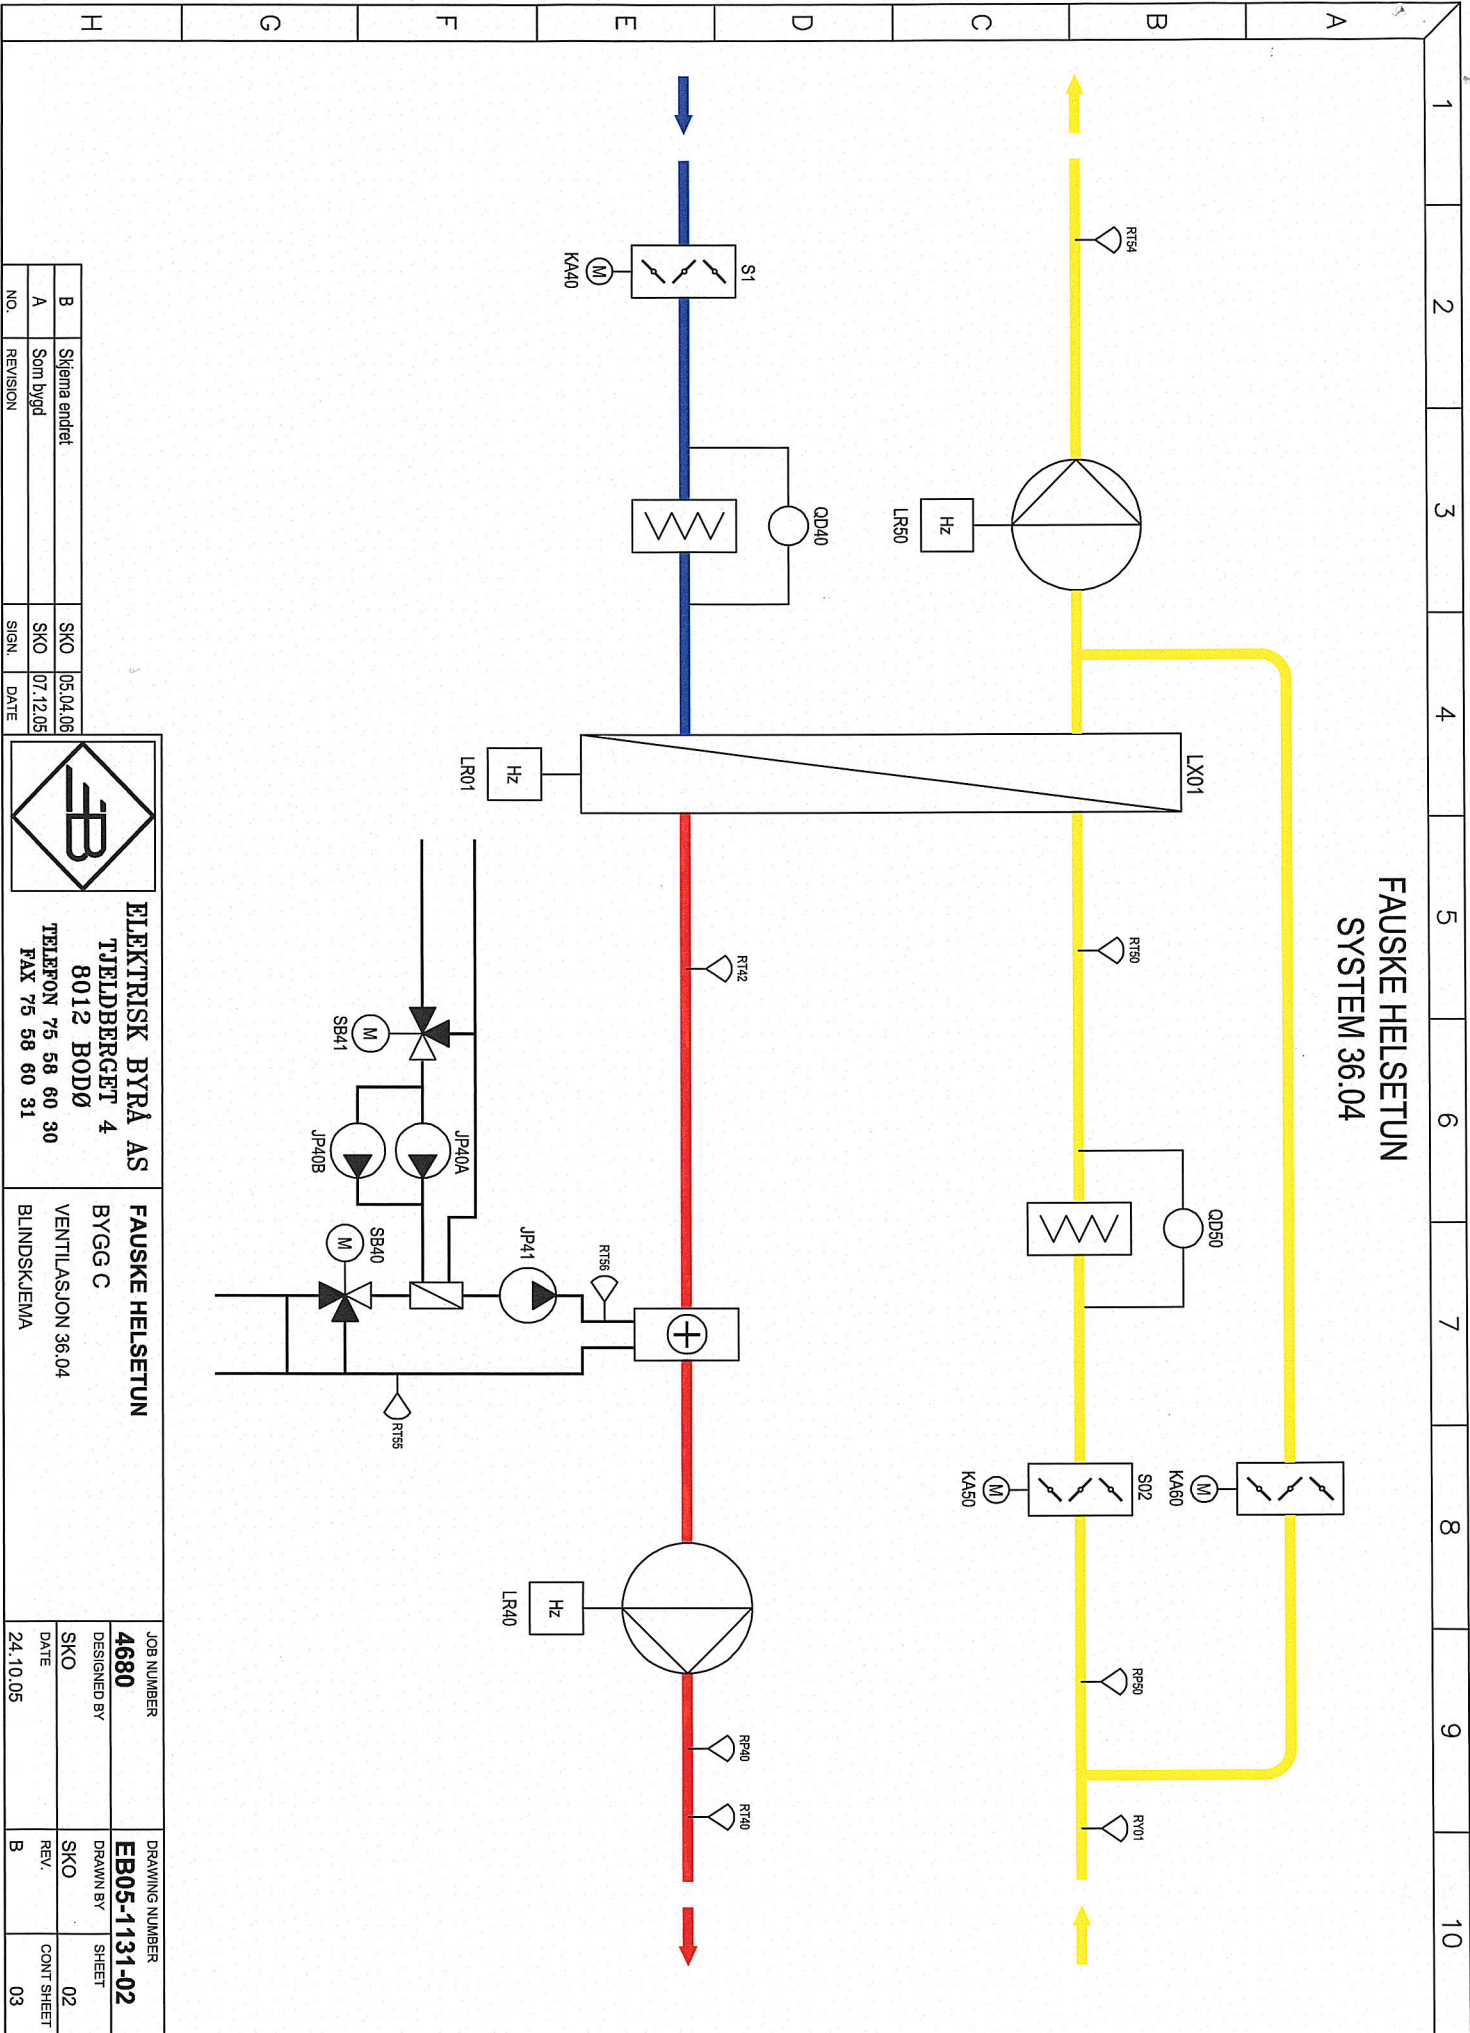



FAUSKE HEISETUN
SYSTEM 36.04

ELEKTRISK BYRÅ AS		FAUSKE HEISETUN	
TJELDBERGET 4		BYGG C	
8012 BODØ		VENTILASJON 36.04	
TELEFON 75 58 60 30		BLINDSKJEMA	
FAX 75 58 60 31			
JOB NUMBER		DRAWING NUMBER	
4680		EB05-1131-02	
DESIGNED BY		DRAWN BY	
SKO		SKO	
DATE		REV.	
24.10.05		B	
SHEET		SHEET	
02		02	
CONT SHEET		CONT SHEET	
03		03	






FAUSKE HEISETUN
SYSTEM 36.04



1	2	3	4	5	6	7	8	9	10
FAUSKE HEISETUN SYSTEM 36.04									

ELEKTRISK BYRÅ AS TJELDBERGET 4 8012 BODØ TELEFON 75 58 60 30 FAX 75 58 60 31		FAUSKE HEISETUN BYGG C VENTILASJON 36.04 BLINDSKJEMA		JOB NUMBER 4680		DRAWING NUMBER EB05-1131-02	
DESIGNED BY SKO		DRAWN BY SKO		SHEET 02		SHEET 03	
DATE 24.10.05		REV. B		COUNT 03		COUNT 03	

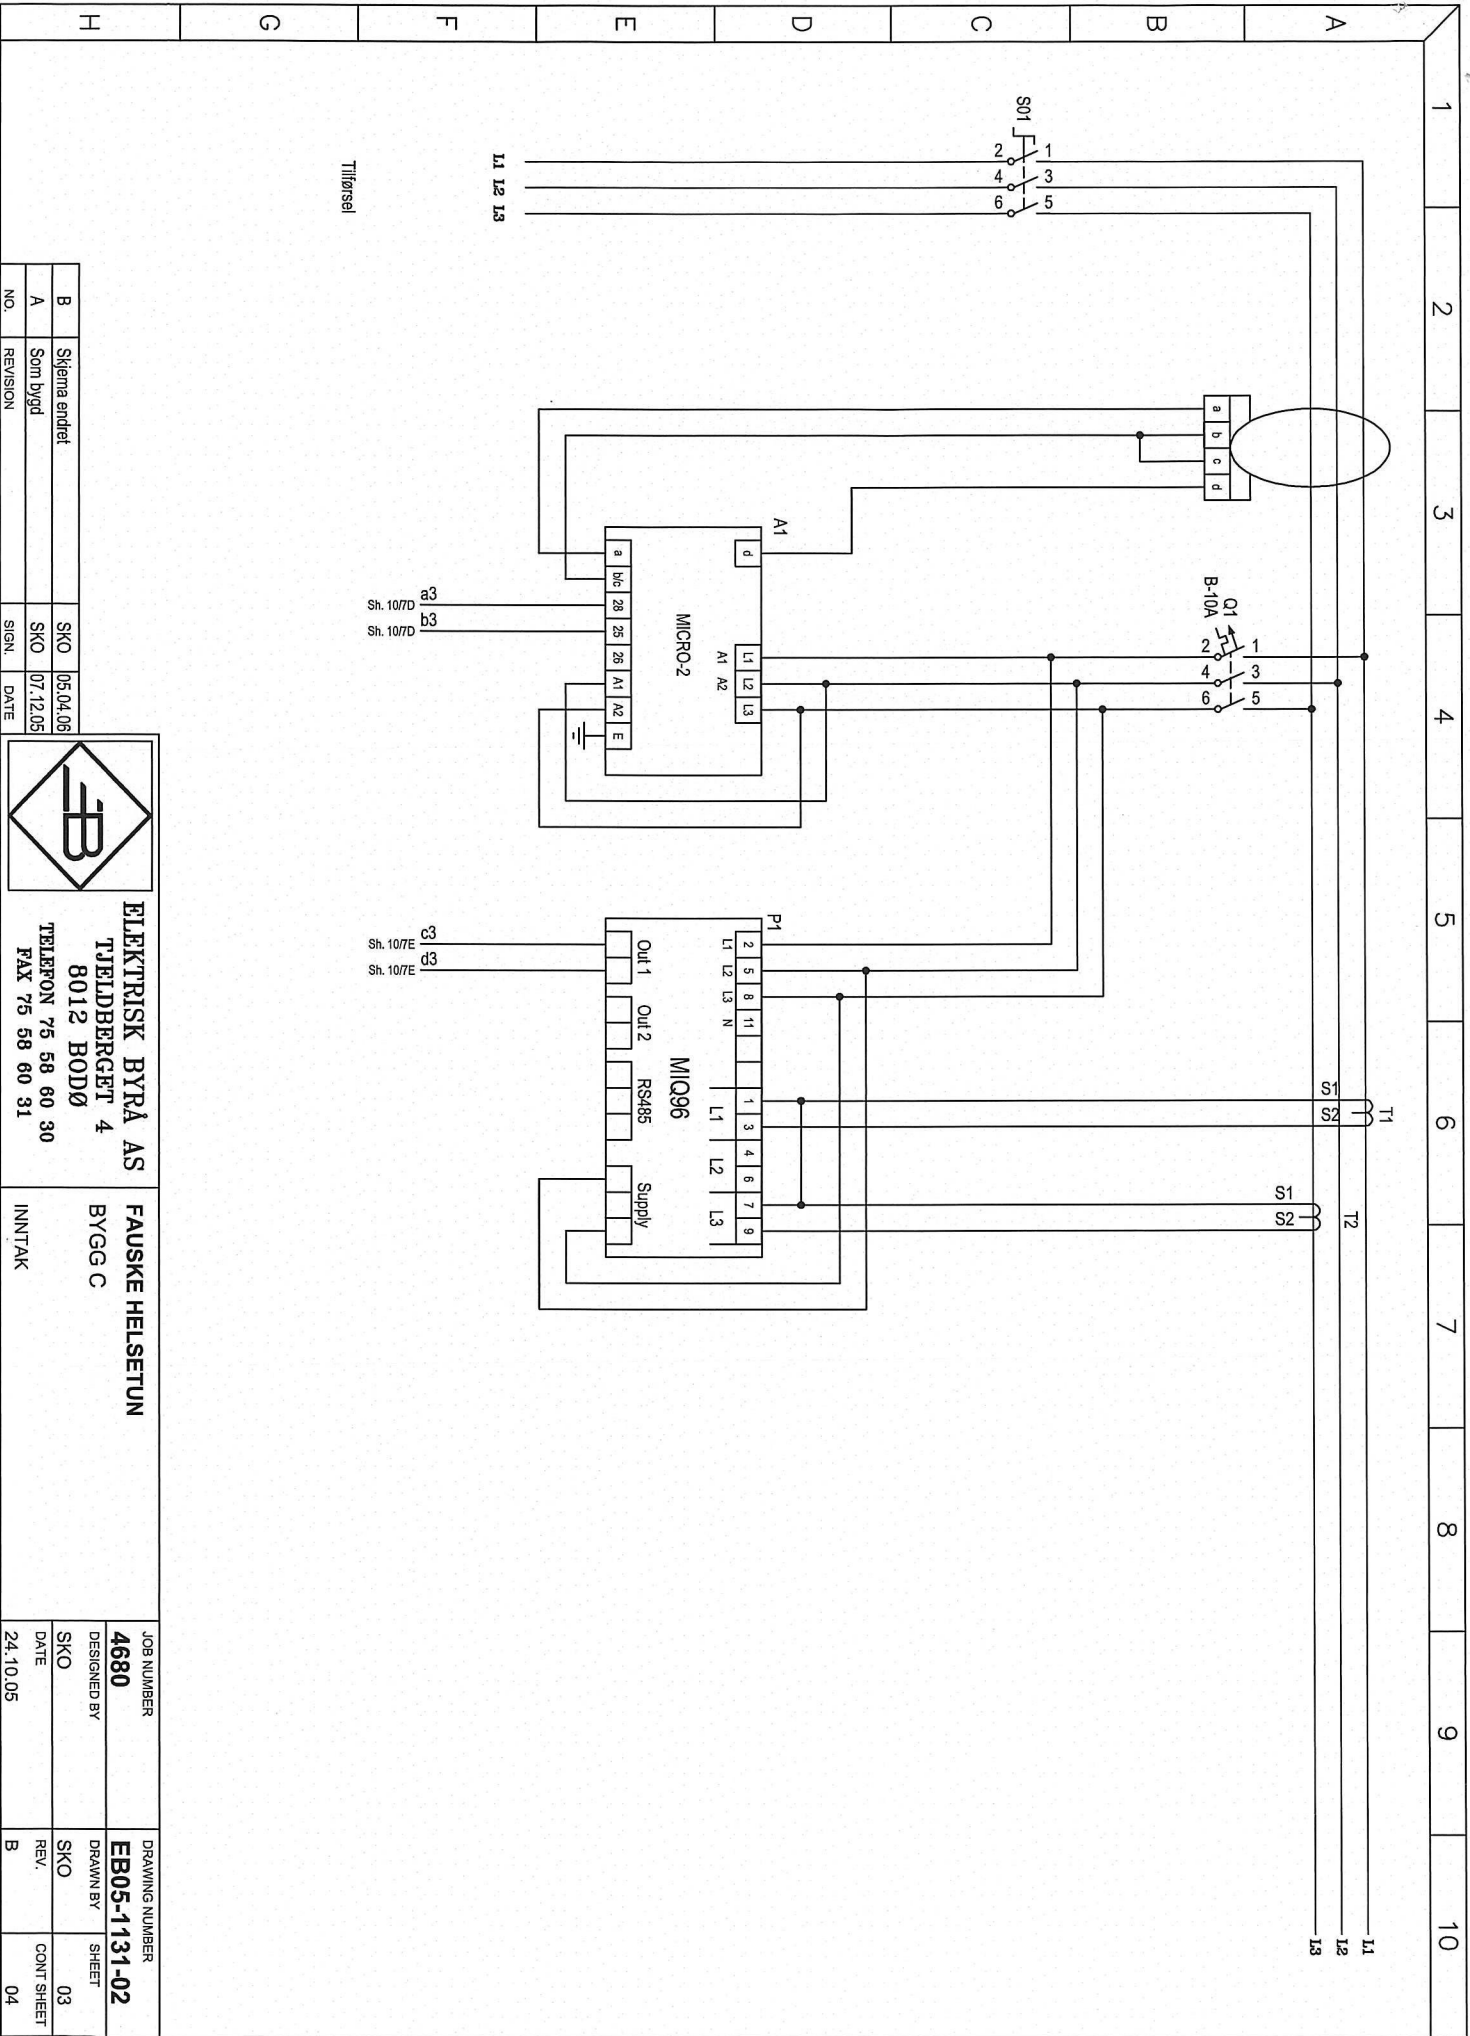


B	Skjema endret	SKO	05.04.06
A	Som bygd	SKO	07.12.05
NO.	REVISION	SIGN.	DATE



ELEKTRISK BYRÅ AS
TJELDBERGET 4
8012 BODØ
TELEFON 75 58 60 30
FAX 75 58 60 31

FAUSKE HEISETUN
BYGG C
INNTAK

JOB NUMBER	4680	DRAWING NUMBER	EB05-1131-02
DESIGNED BY	SKO	DRAWN BY	SKO
DATE	24.10.05	REV.	B
		SHEET	03
		COUNT SHEET	04

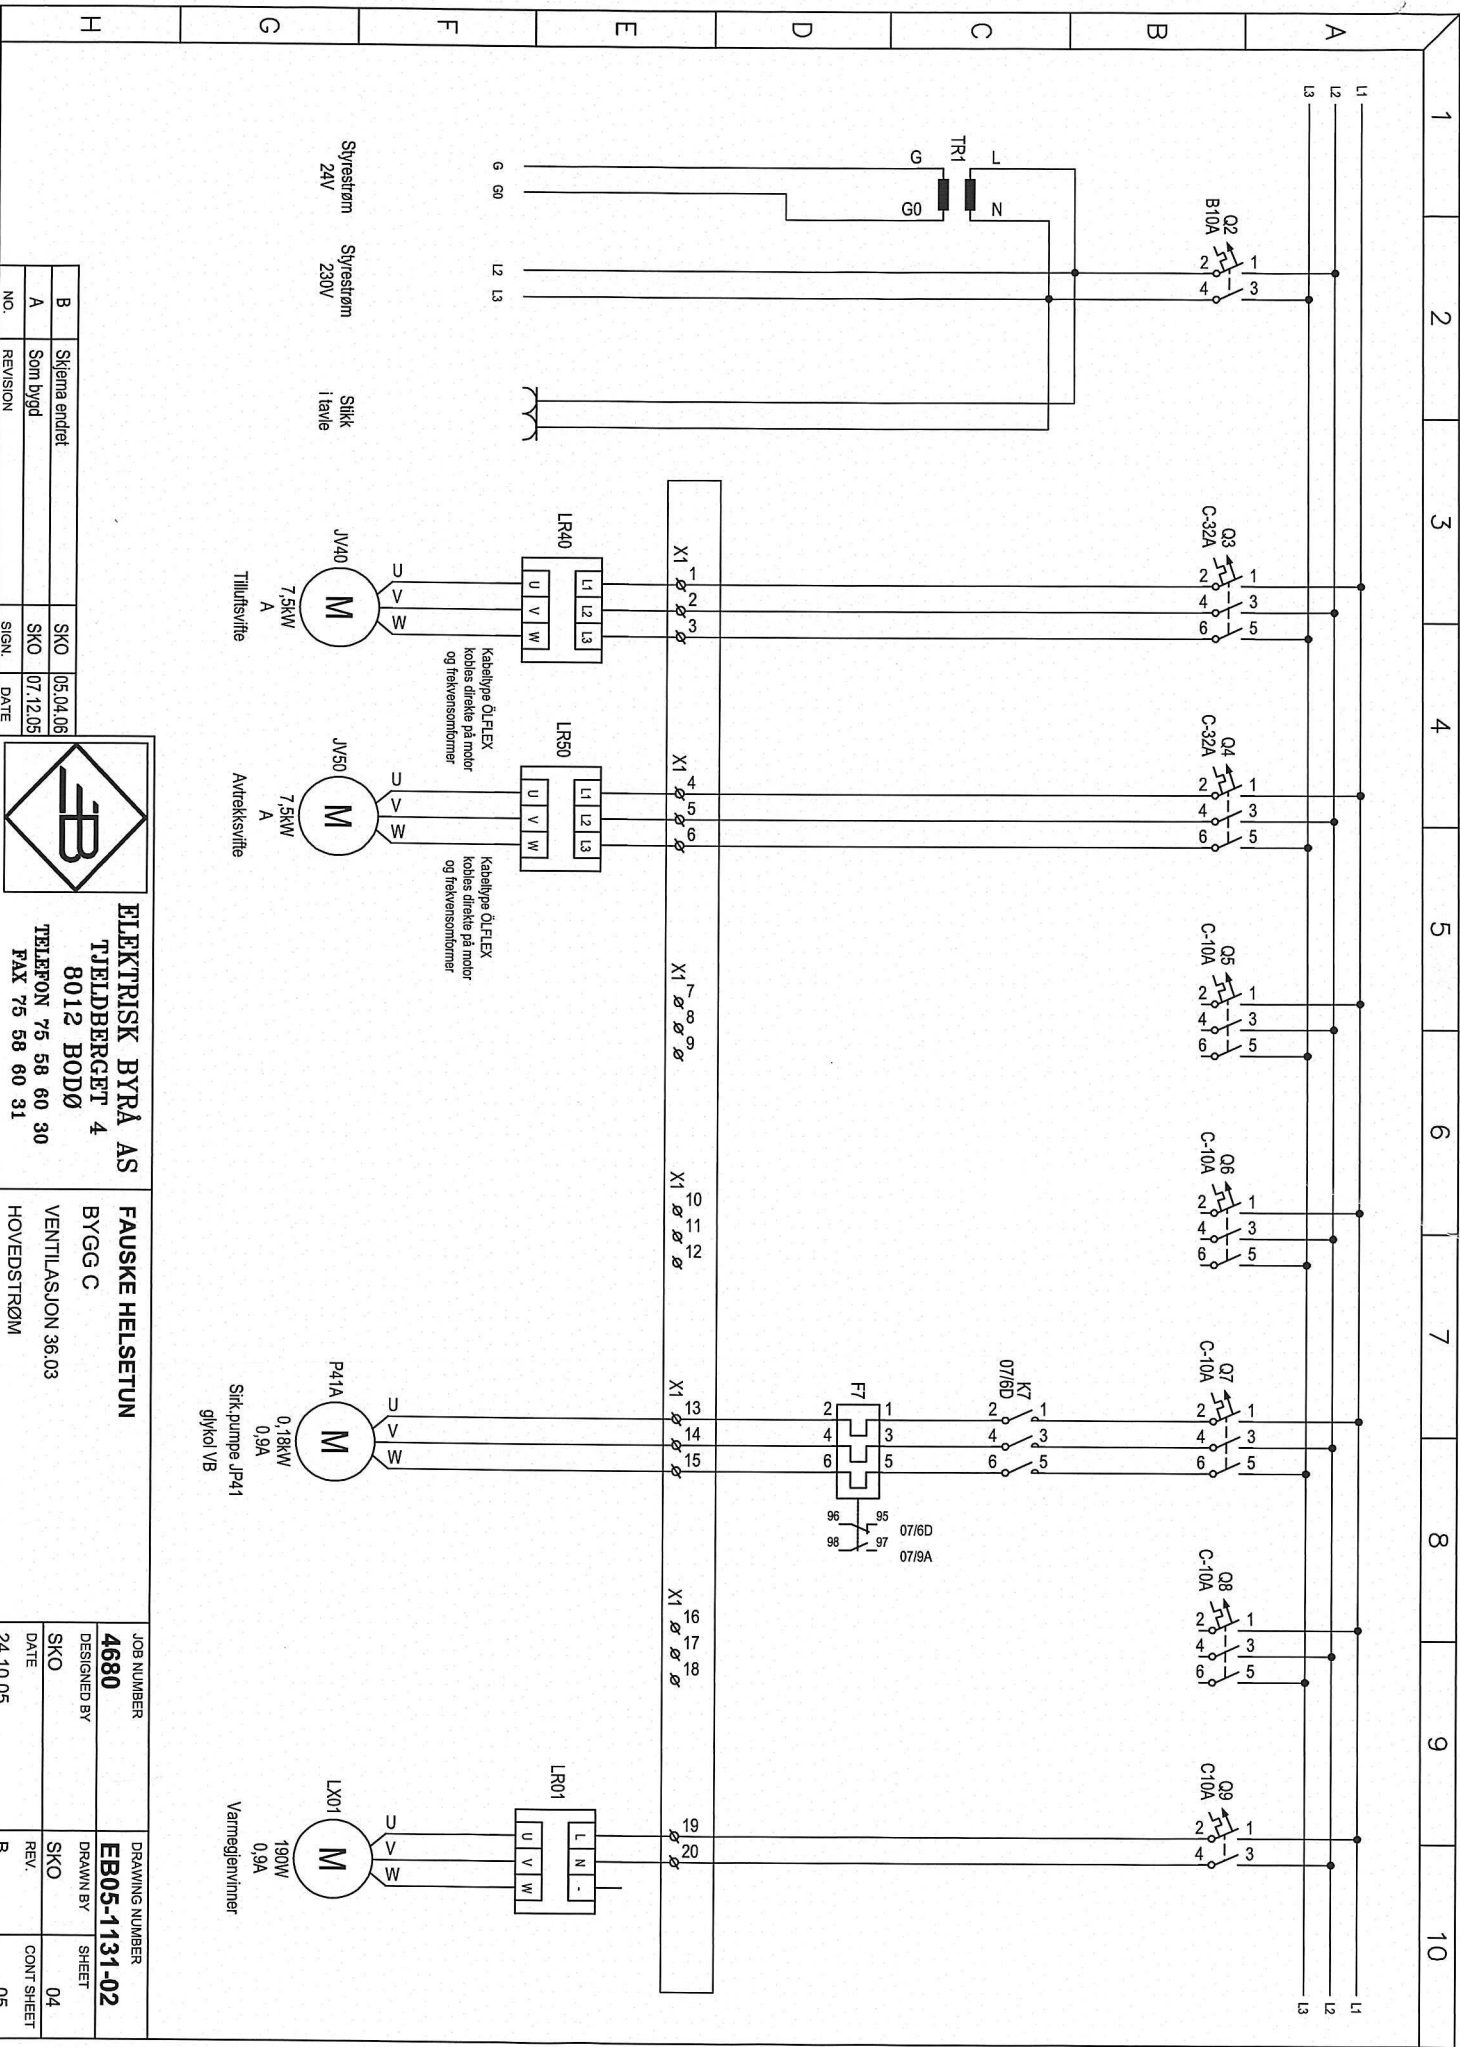


B	Skema endret	SKO	05.04.06
A	Son bygd	SKO	07.12.05
NO.	REVISION	SIGN.	DATE




ELEKTRISK BYRÅ AS
TJELDBERGET 4
8012 BODØ
TELEFON 75 58 60 30
FAX 75 58 60 31



FAUSKE HELSETUN
BYGG C
VENTILASJON 36.03
HOVEDSTRØM

JOB NUMBER	DRAWING NUMBER
4680	EB05-1131-02
DESIGNED BY	DRAWN BY
SKO	SKO
DATE	REV.
24.10.05	B
SHEET	COUNT SHEET
04	05

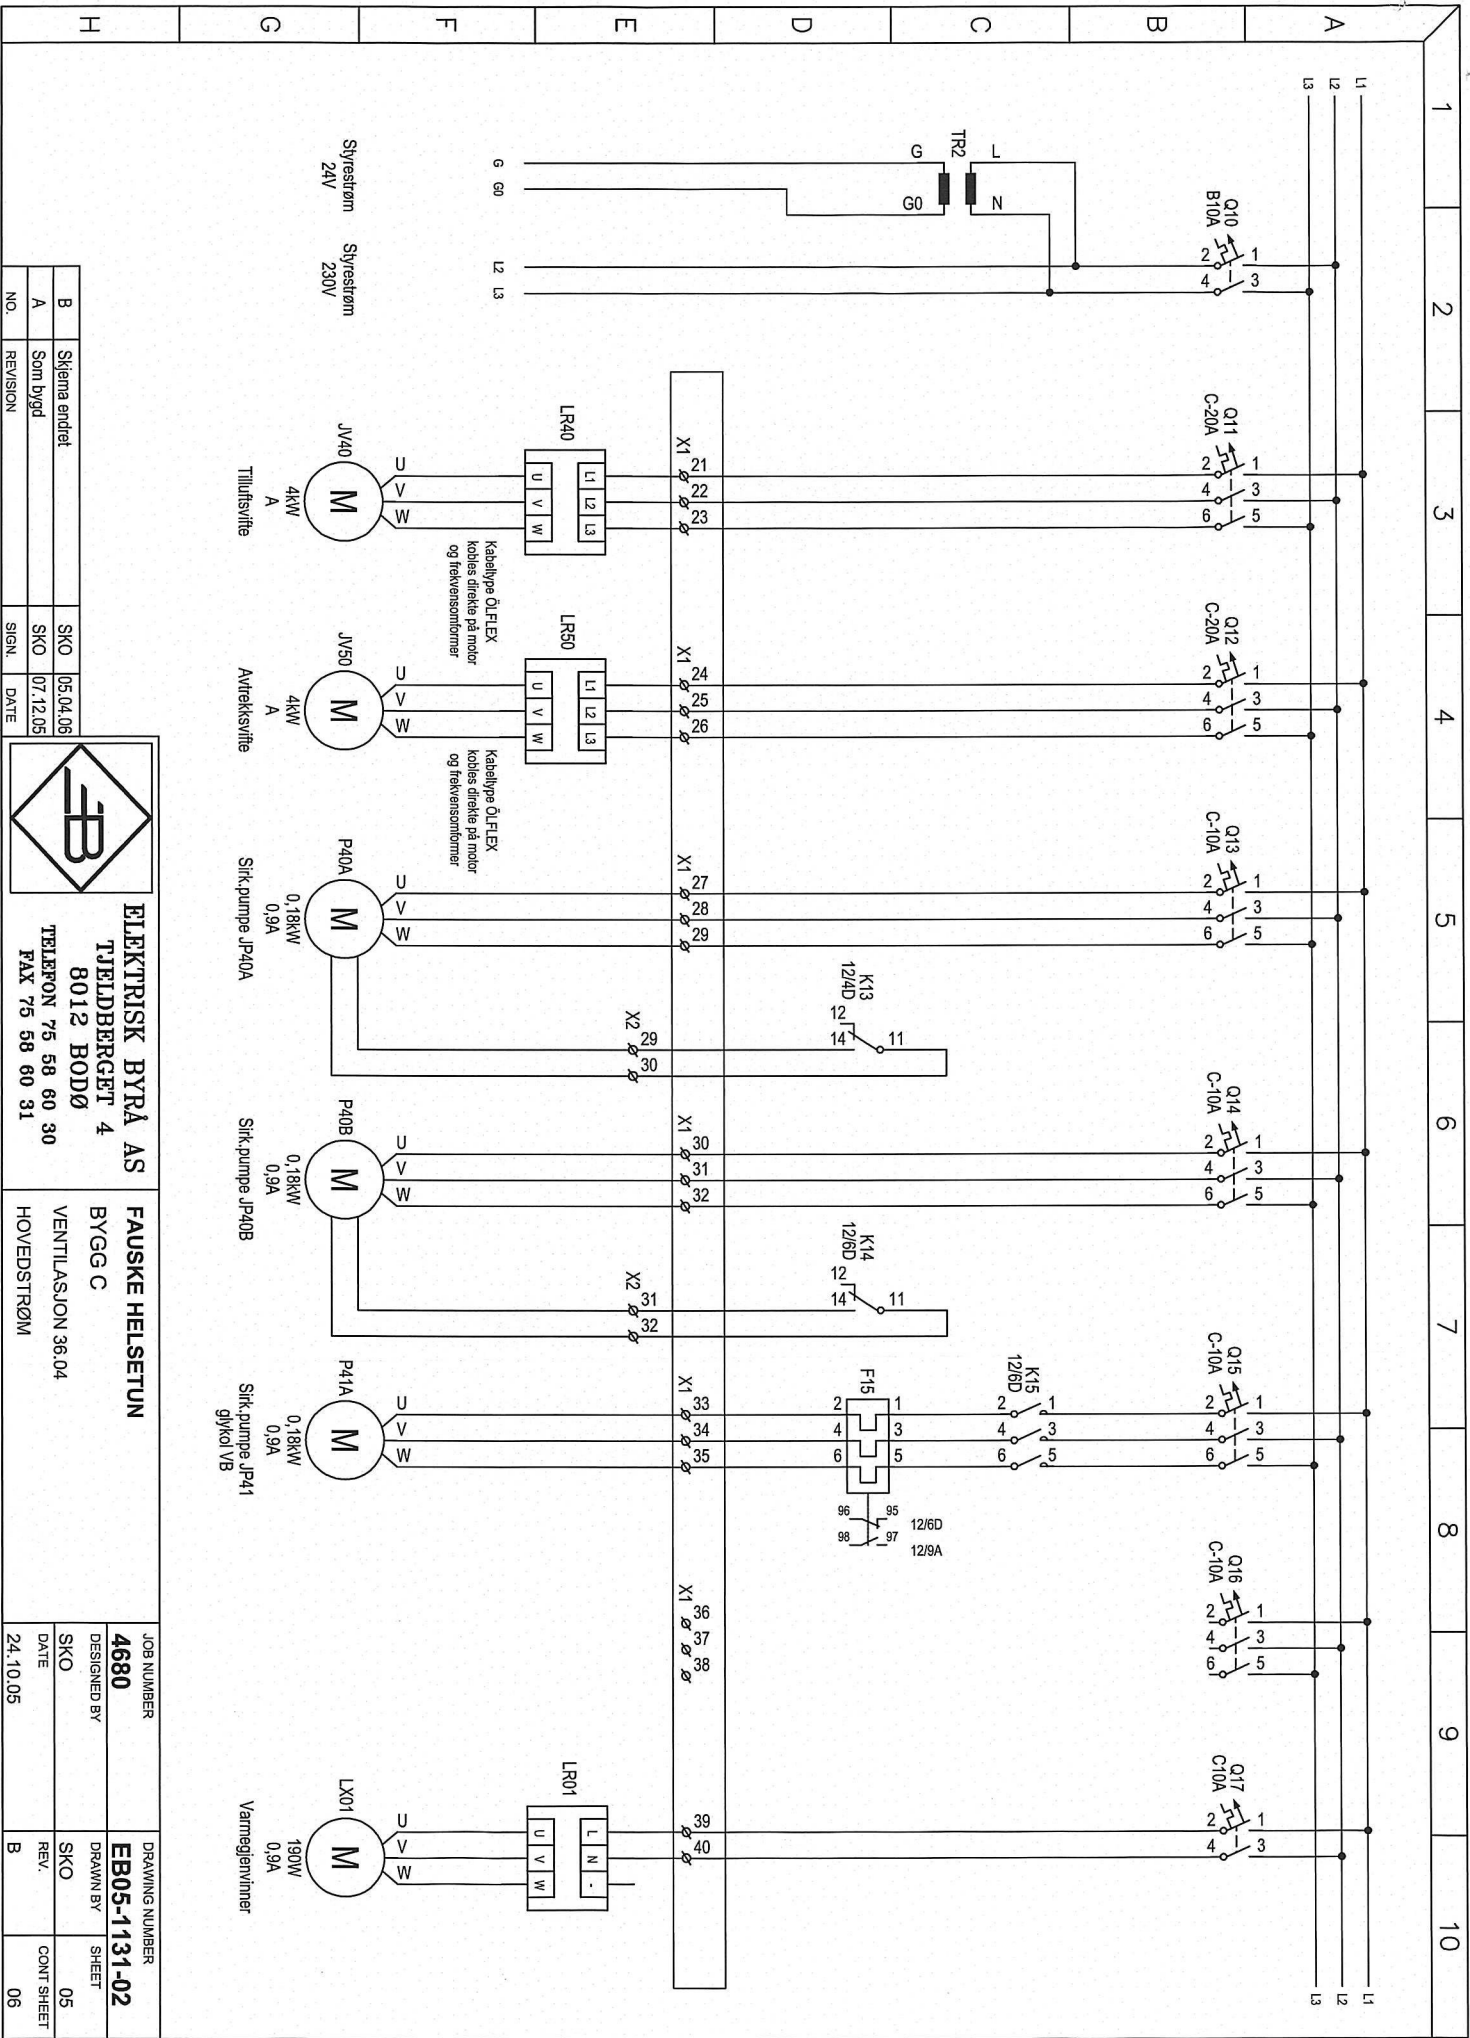

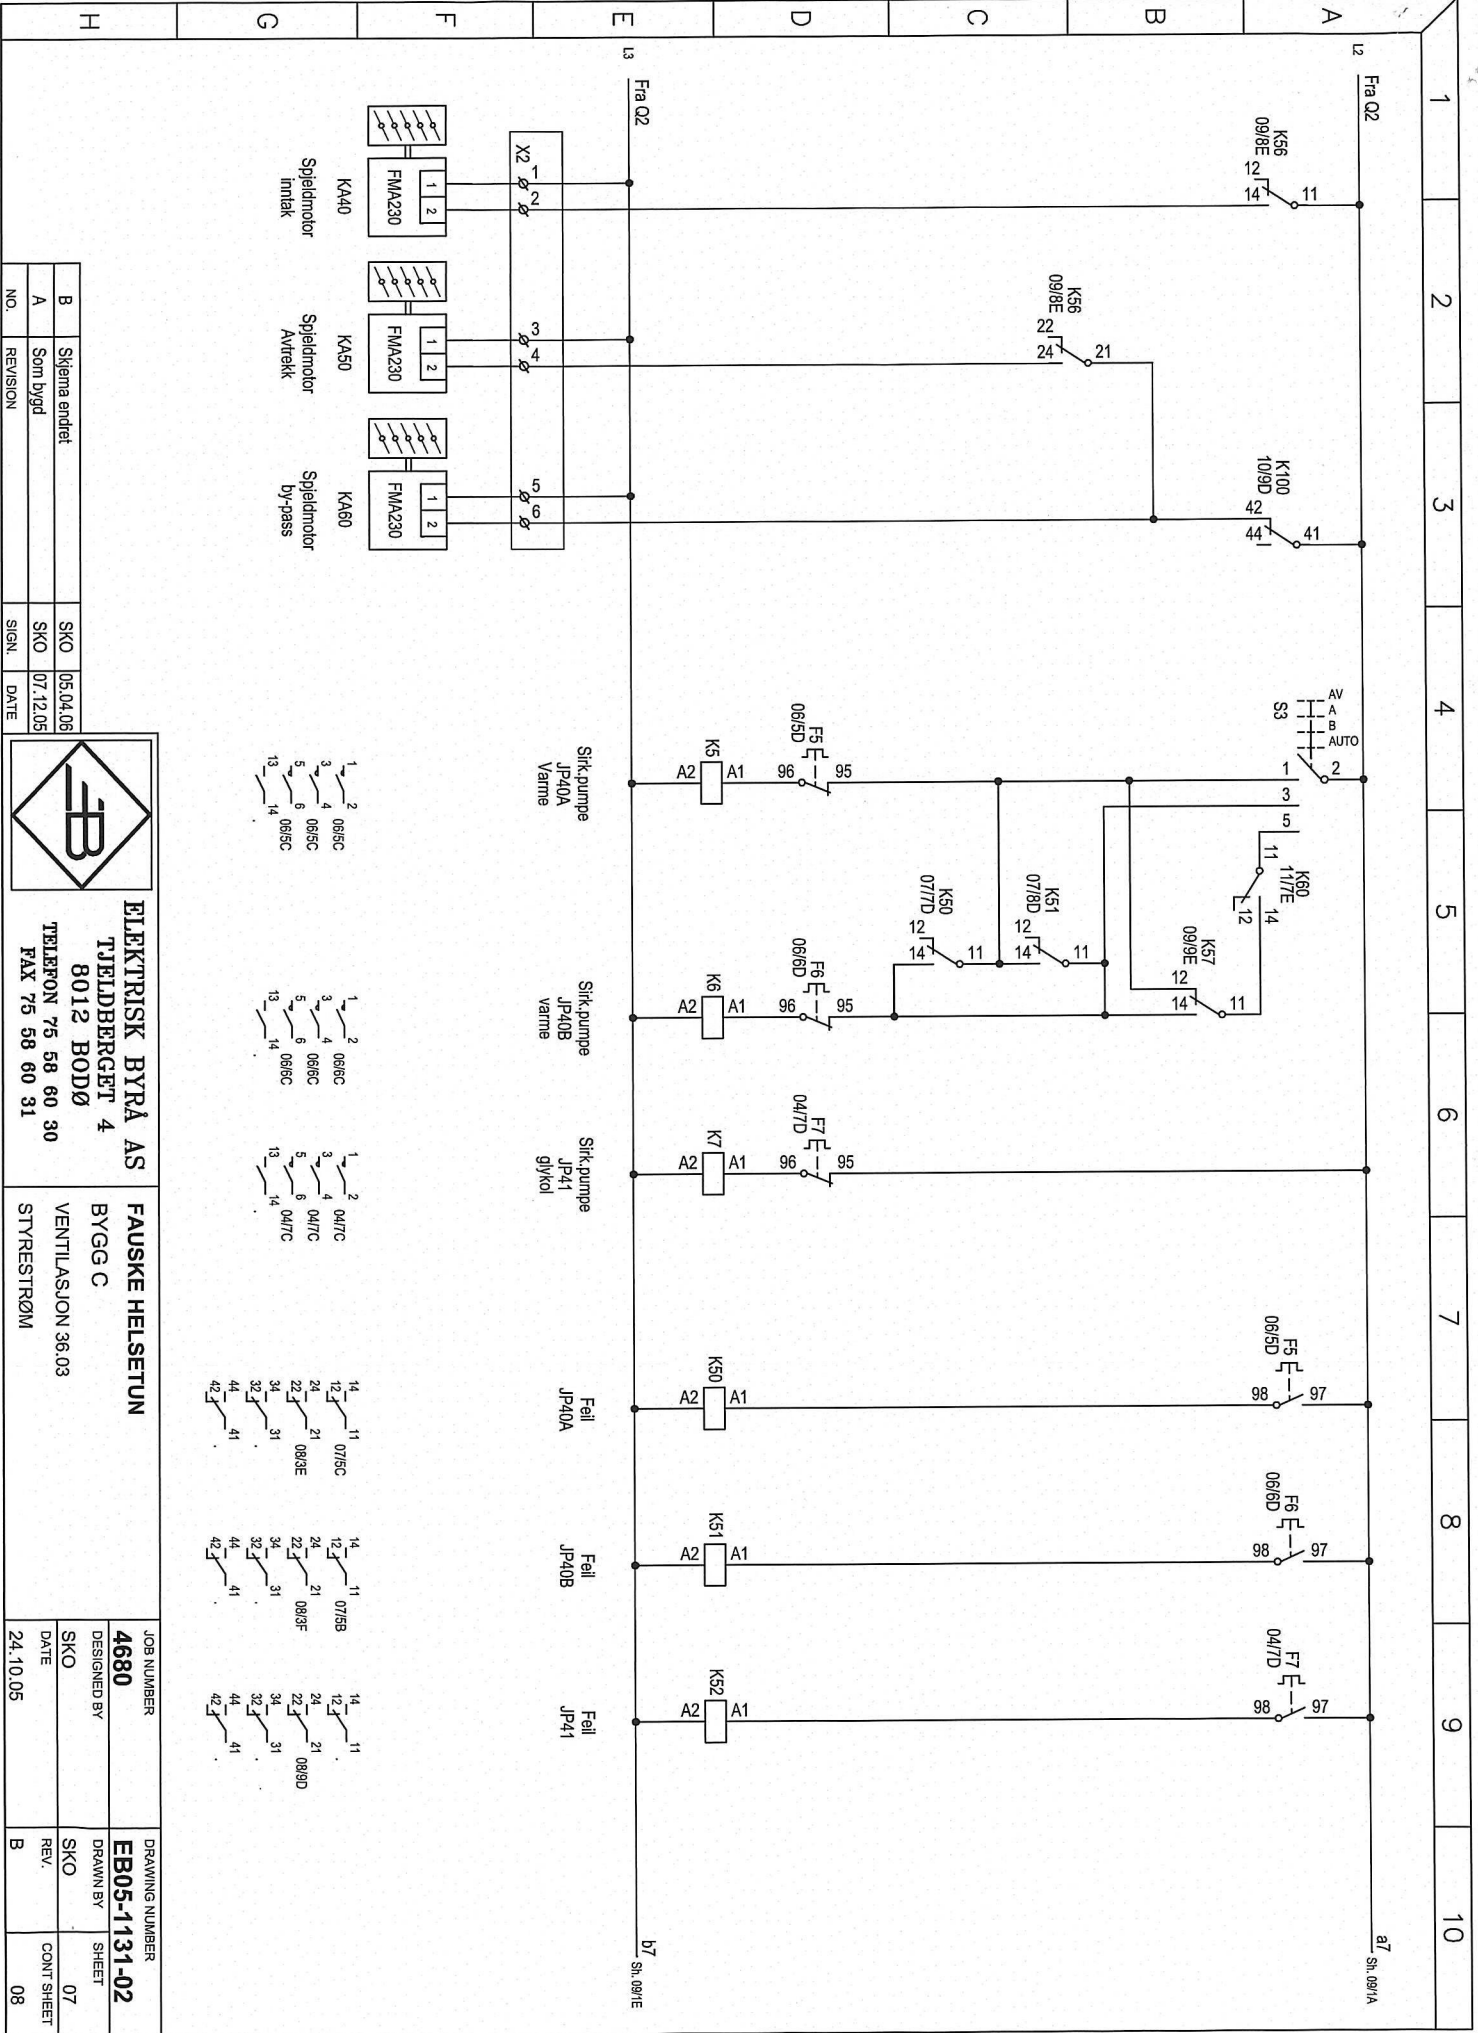




TA XENTA 302-BASE

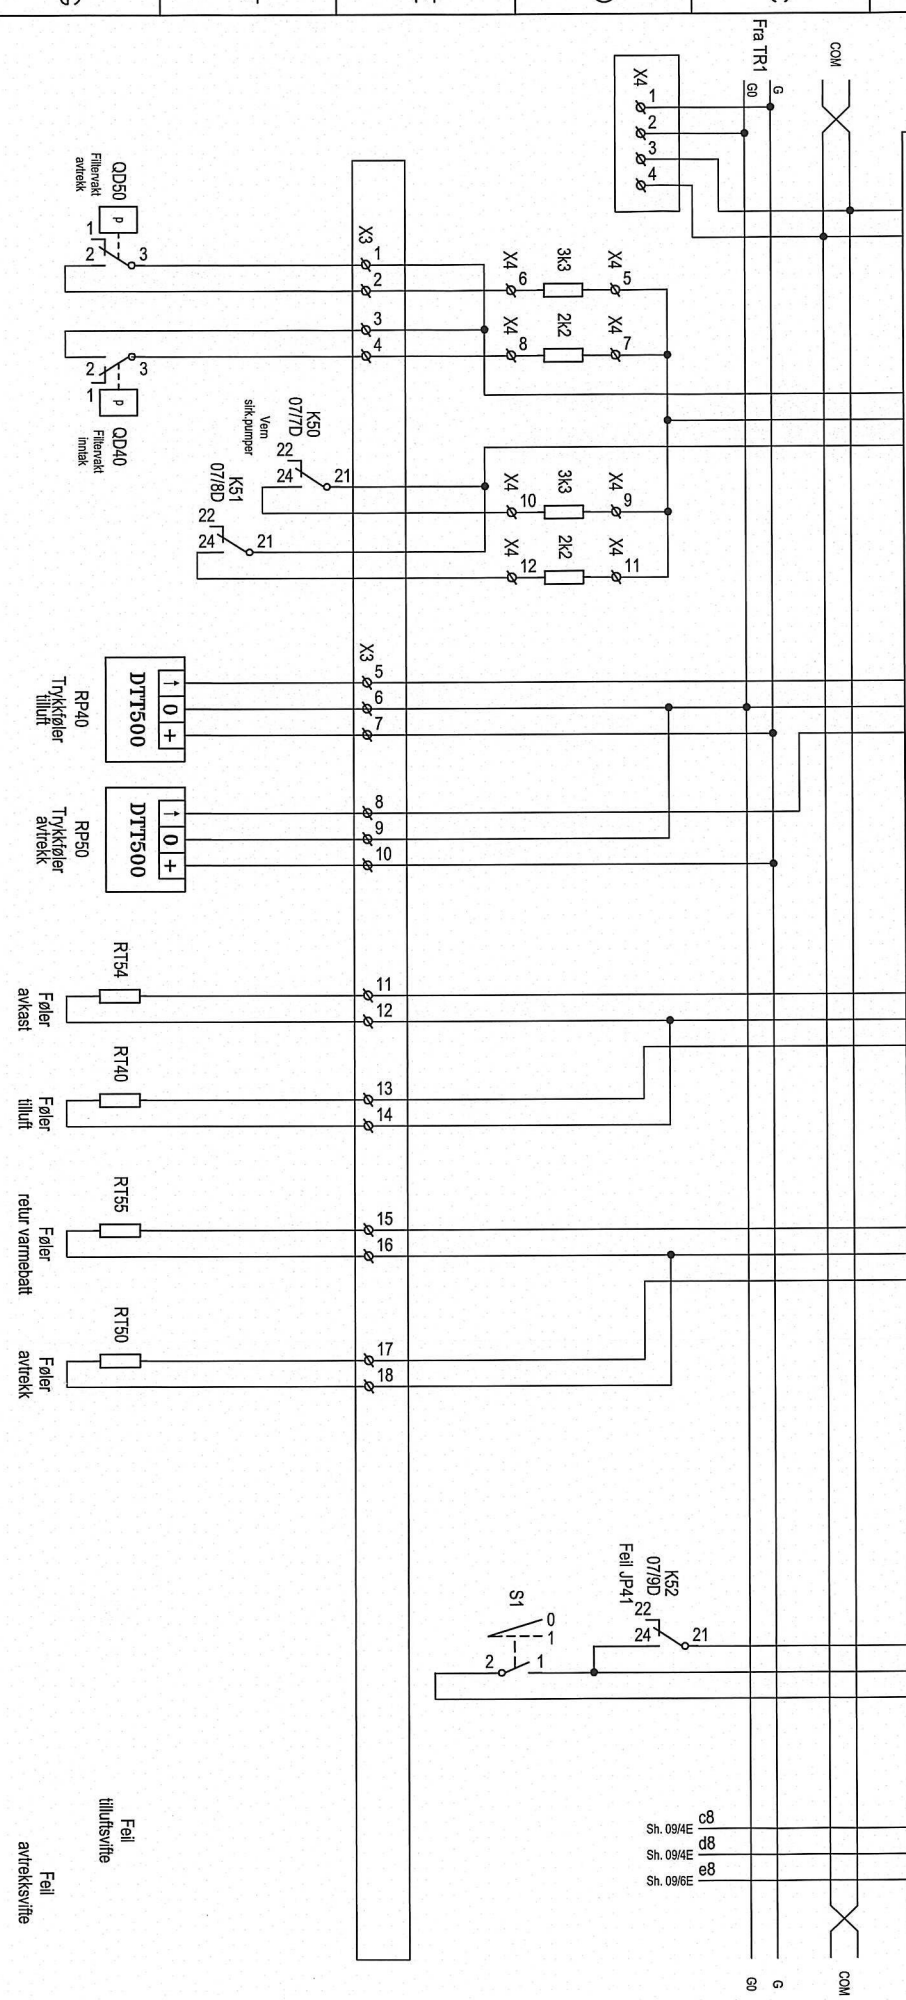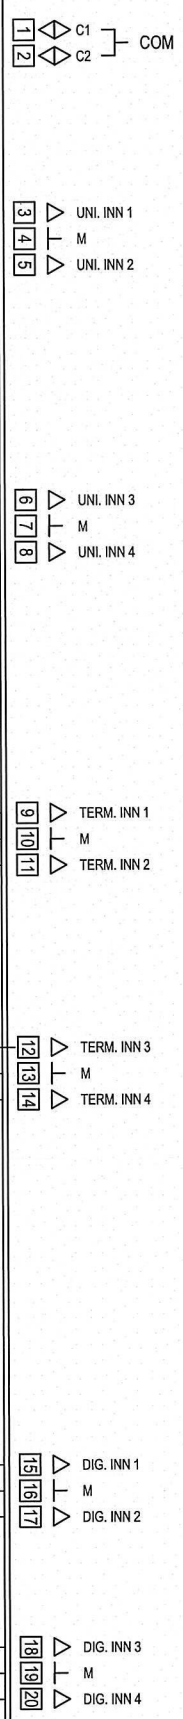

ELEKTRISK BYRÅ AS		FAUSKE HELESETUN	
TJELDBERG 4		BYGG C	
8012 BODØ		VENTILASJON 36.03	
TELEFON 75 58 60 30		STYRESTRØM	
FAX 75 58 60 31			
B	Schema endret	SKO	05.04.06
A	Som bygd	SKO	07.12.05
NO.	REVISION	SIGN.	DATE
JOB NUMBER 4680		DRAWING NUMBER EB05-1131-02	
DESIGNED BY SKO		DRAWN BY SKO	
DATE 24.10.05		REV. B	
		SHEET 08	
		CONT SHEET 09	

Sh. 07/10A a7 l2 TC01 Sh. 11/1A a8



TA XENTA 302-BASE

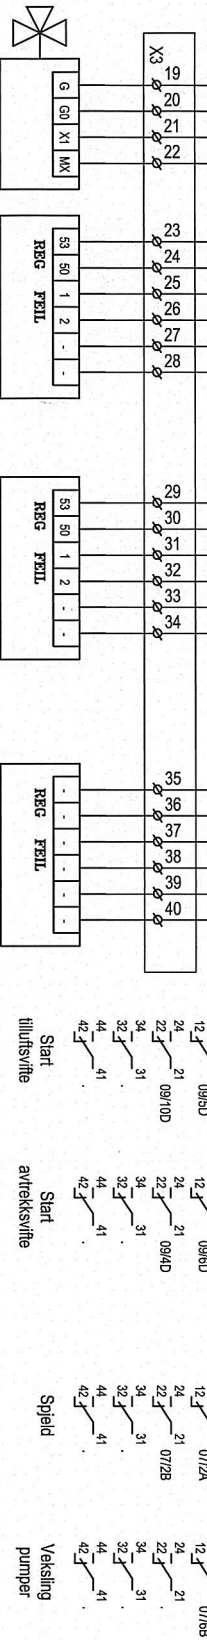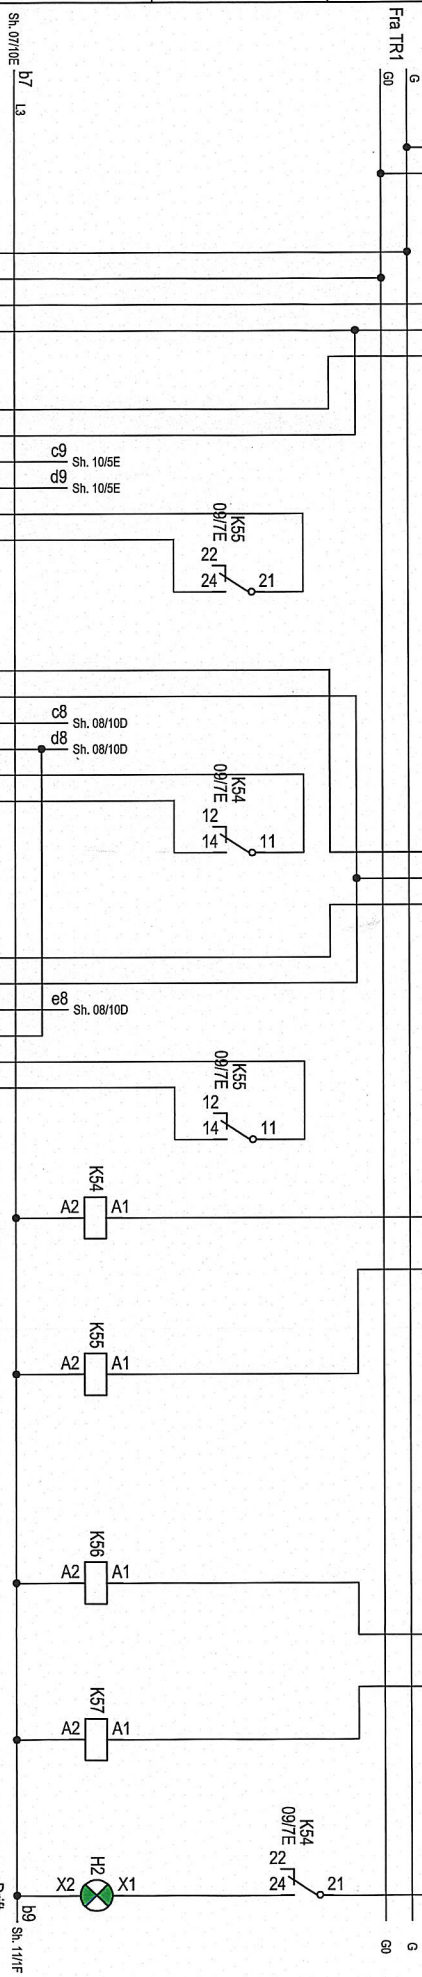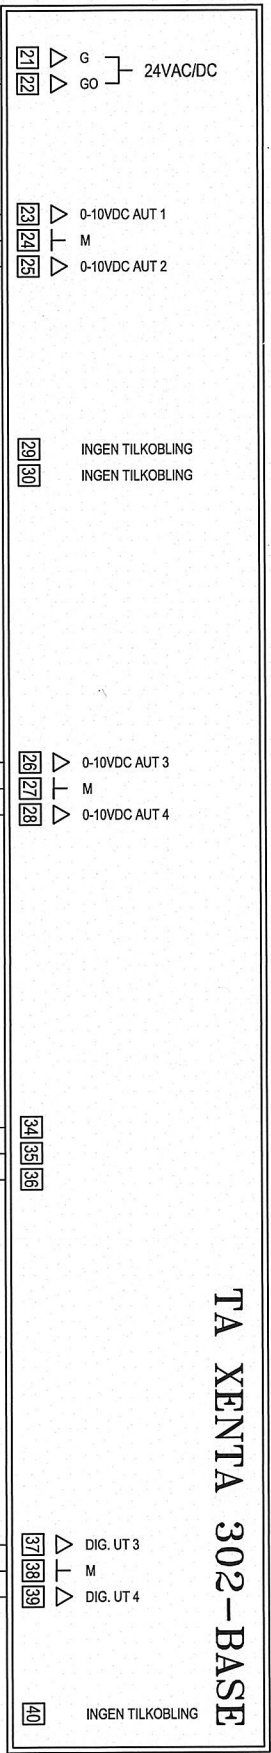

ELEKTRISK BYRÅ AS				FAUSKE HELESTUN			
TJELDBERG 4				BYGG C			
8012 BODØ				VENTILASJON 36.03			
TELEFON 75 58 60 30				STYRESTRØM			
FAX 75 58 60 31							
B	Skema endret	SKO	05.04.06	JOB NUMBER	4680	DRAWN BY	SKO
A	Som bygd	SKO	07.12.05	DESIGNED BY	SKO	REV.	SKO
NO.	REVISION	SIGN.	DATE	DATE	24.10.05	REV.	SKO
				CONTR. SHEET	09	CONTR. SHEET	10

36.03_QU01_M1

TA XENTA 451/452 I/O

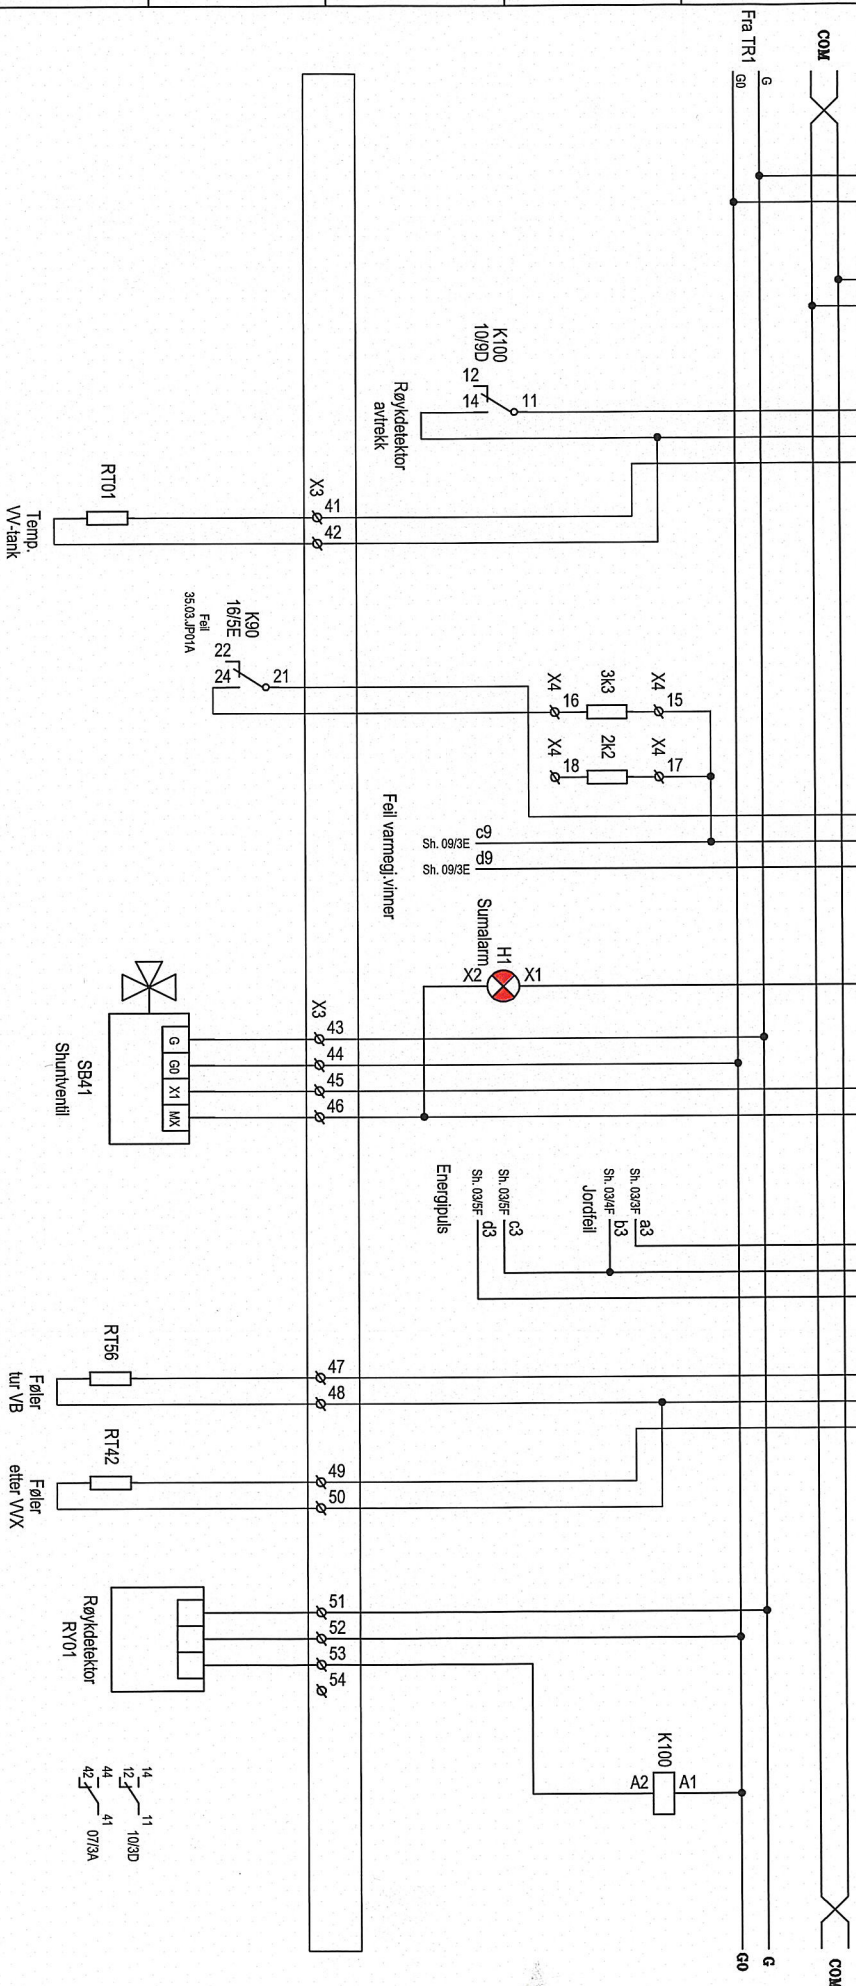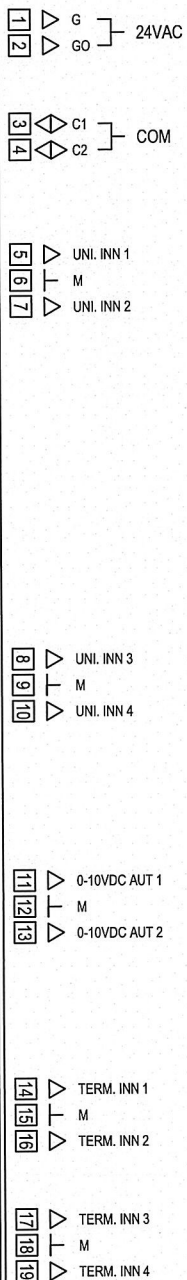

B	Skjema endret	SKO	05.04.06
A	Som bygd	SKO	07.12.05
NO.	REVISION	SIGN.	DATE





ELEKTRISK BYRÅ AS
TJELDBERGET 4
8012 BODØ
TELEFON 75 58 60 30
FAX 75 58 60 31

FAUSKE HELSETUN
BYGG C
VENTILASJON 36.03
STYRESTRØM


JOB NUMBER	4680	DRAWING NUMBER	EB05-1131-02
DESIGNED BY	SKO	DRAWN BY	SKO
DATE	24.10.05	REV.	B
CON'T SHEET	11		



TA XENTA 421A

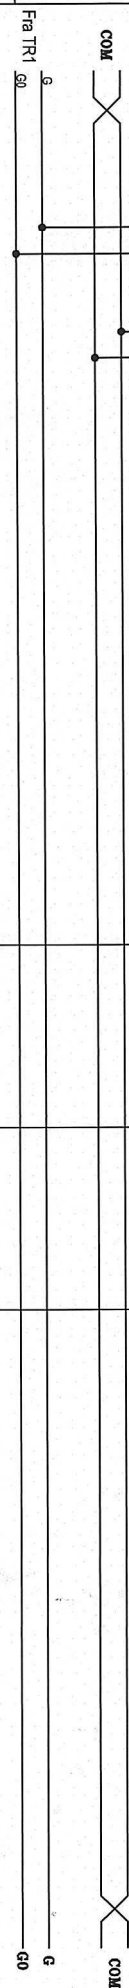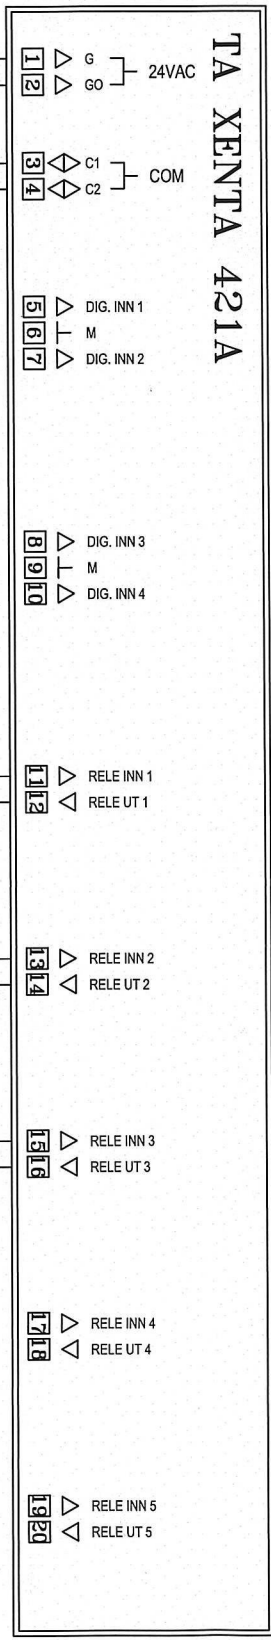

SH. 09/10E 09 L3 13

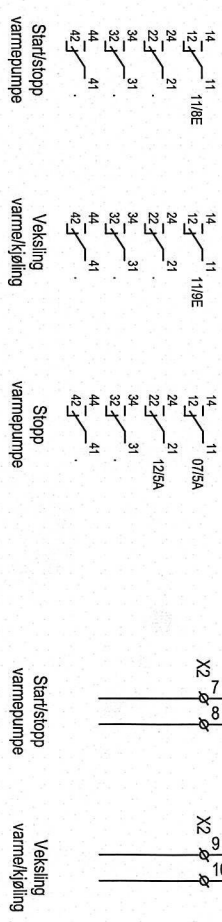


B	Skjema endret	SKO	05.04.06
A	Som bygd	SKO	07.12.05
NO.	REVISION	SIGN.	DATE

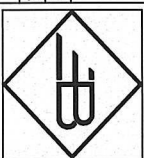

ELEKTRISK BYRÅ AS
TJELDBERGET 4
8012 BODØ
TELEFON 75 58 60 30
FAX 75 58 60 31

FAUSKE HELSETUN
BYGG C
VENTILASJON 36.03
STYRESTRØM

JOB NUMBER	4680	DRAWING NUMBER	EB05-1131-02
DESIGNED BY	SKO	DRAWN BY	SKO
DATE	24.10.05	REV.	B
		SHEET	11
		CONT SHEET	12

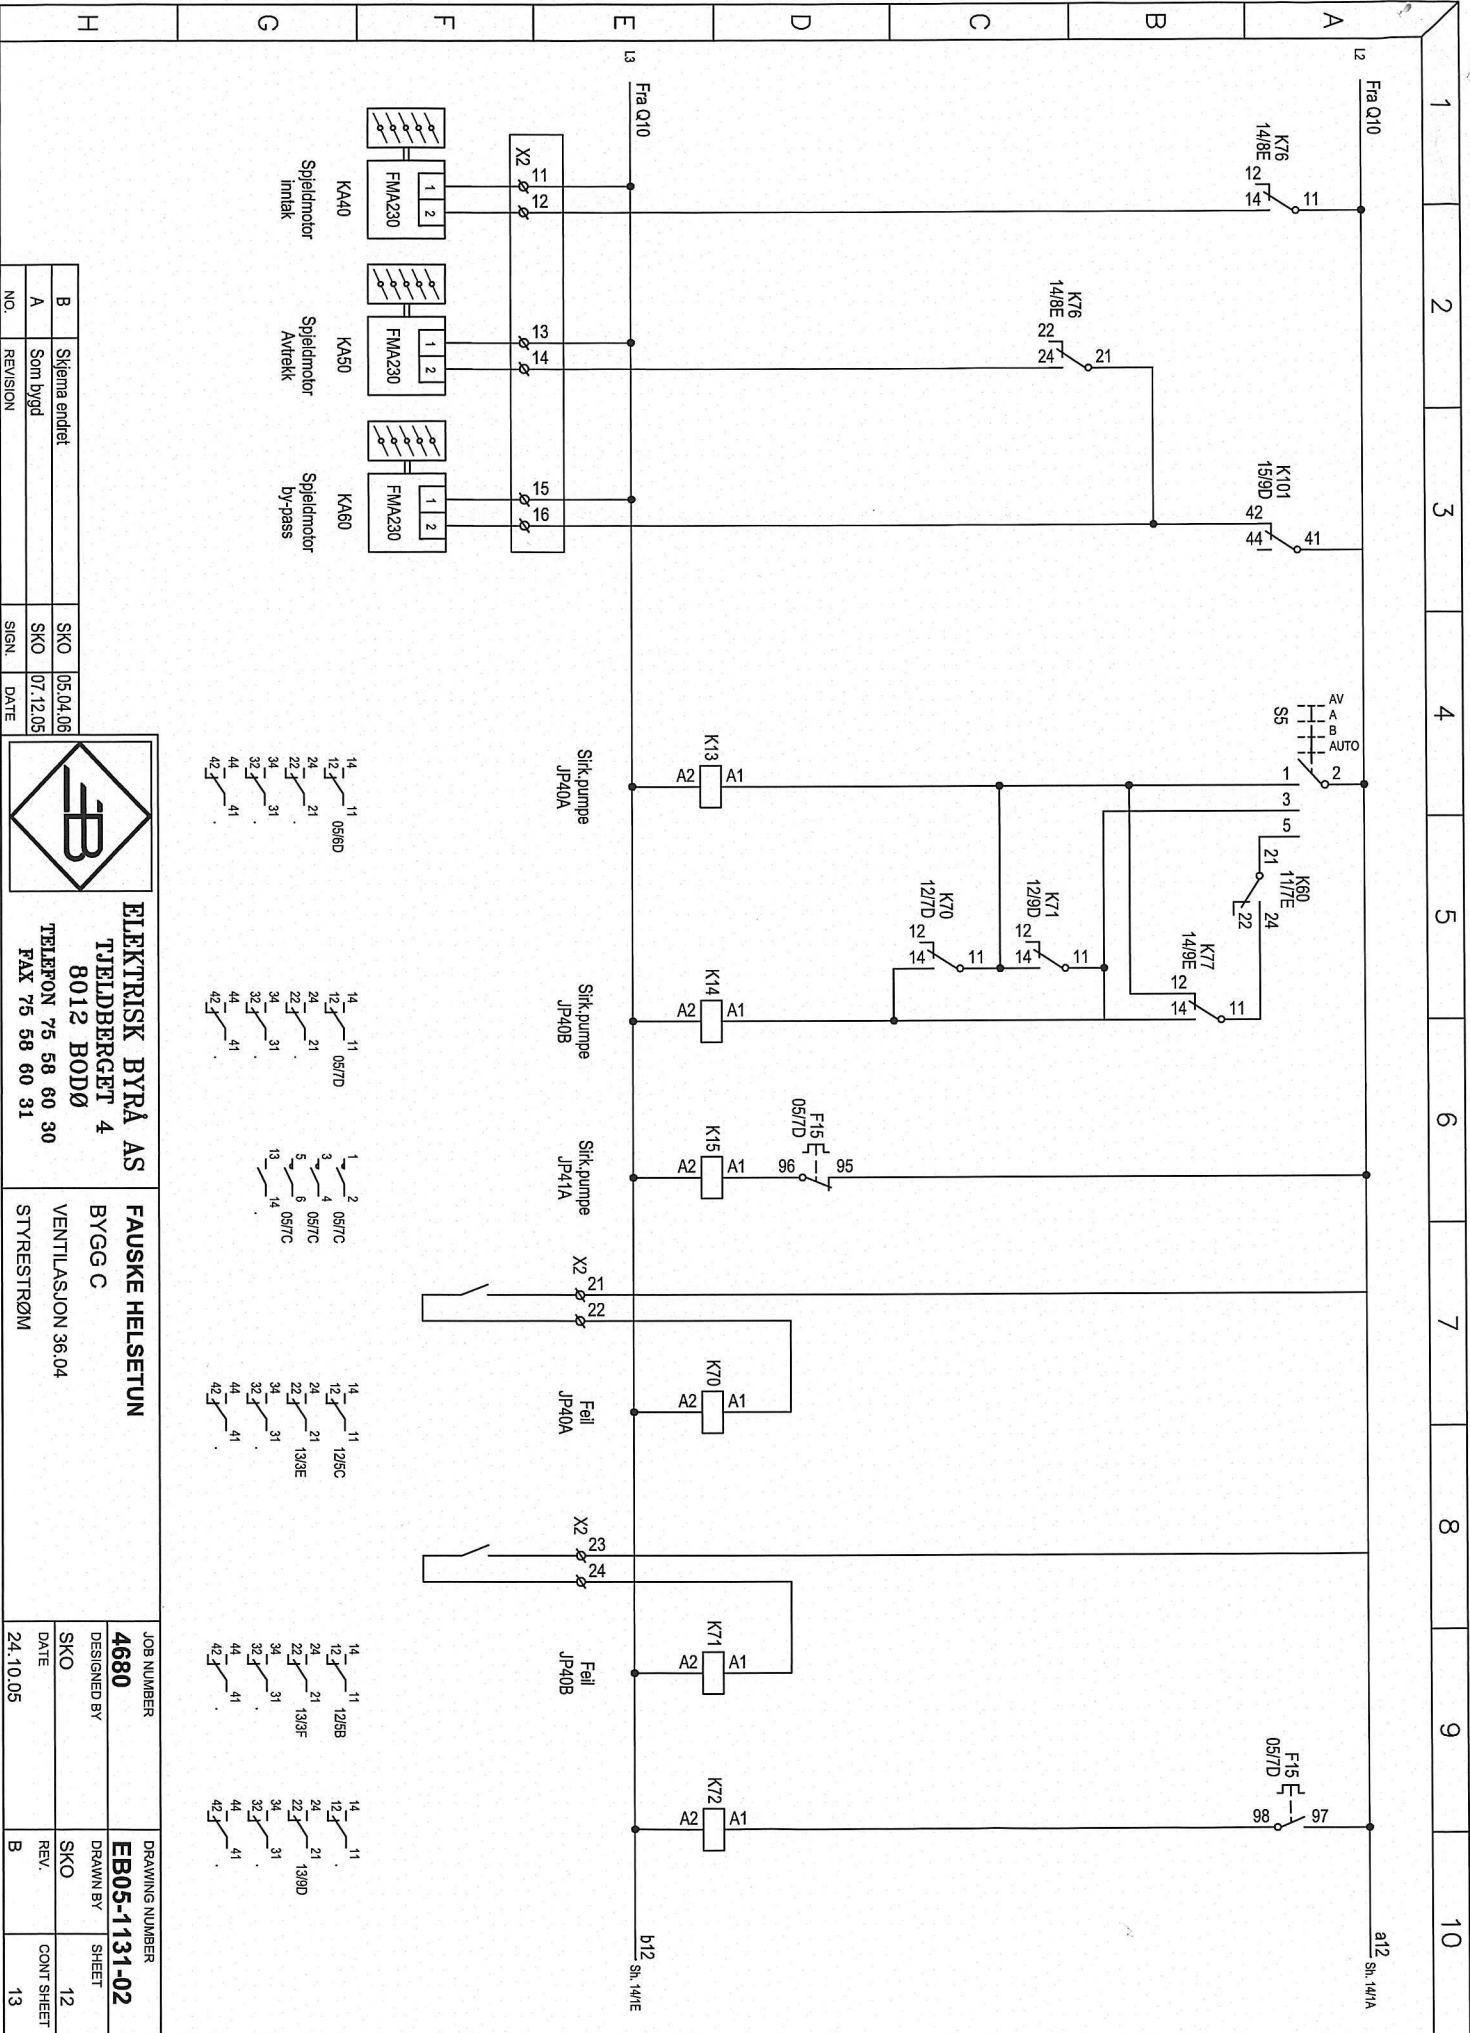

B	Skjema endret	SKO	05.04.06
A	Som bygd	SKO	07.12.05
NO.	REVISION	SIGN.	DATE



ELEKTRISK BYRÅ AS
TJELDBERGSET 4
8012 BODØ
TELEFON 75 58 60 30
FAX 75 58 60 31


FAUSKE HELSETUN
BYGG C
VENTILASJON 36.04
STYRESTRØM

JOB NUMBER	4680	DRAWING NUMBER	EB05-1131-02
DESIGNED BY	SKO	DRAWN BY	SKO
DATE	24.10.05	REV.	B
		SHEET	12
		CONT SHEET	13


Sh. 12/10A a12 12

TC01

Sh. 16/1A a14

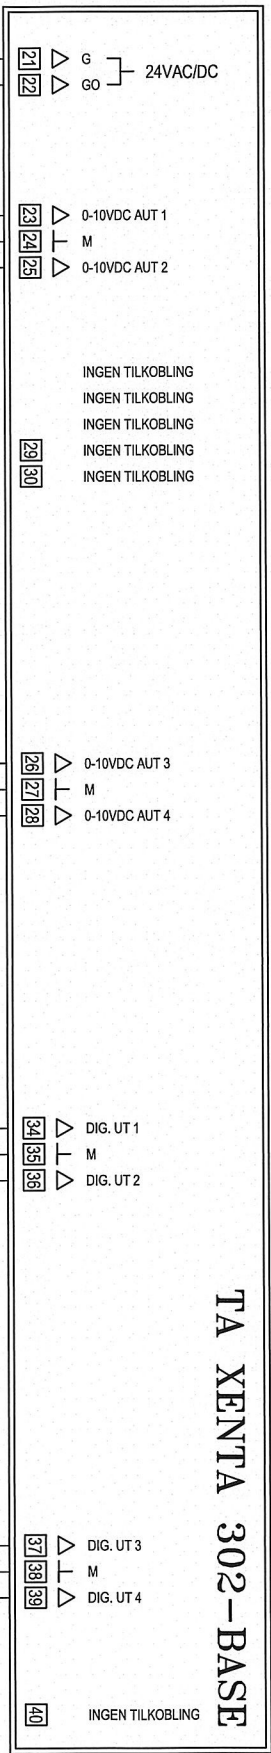


TA XENTA 302-BASE

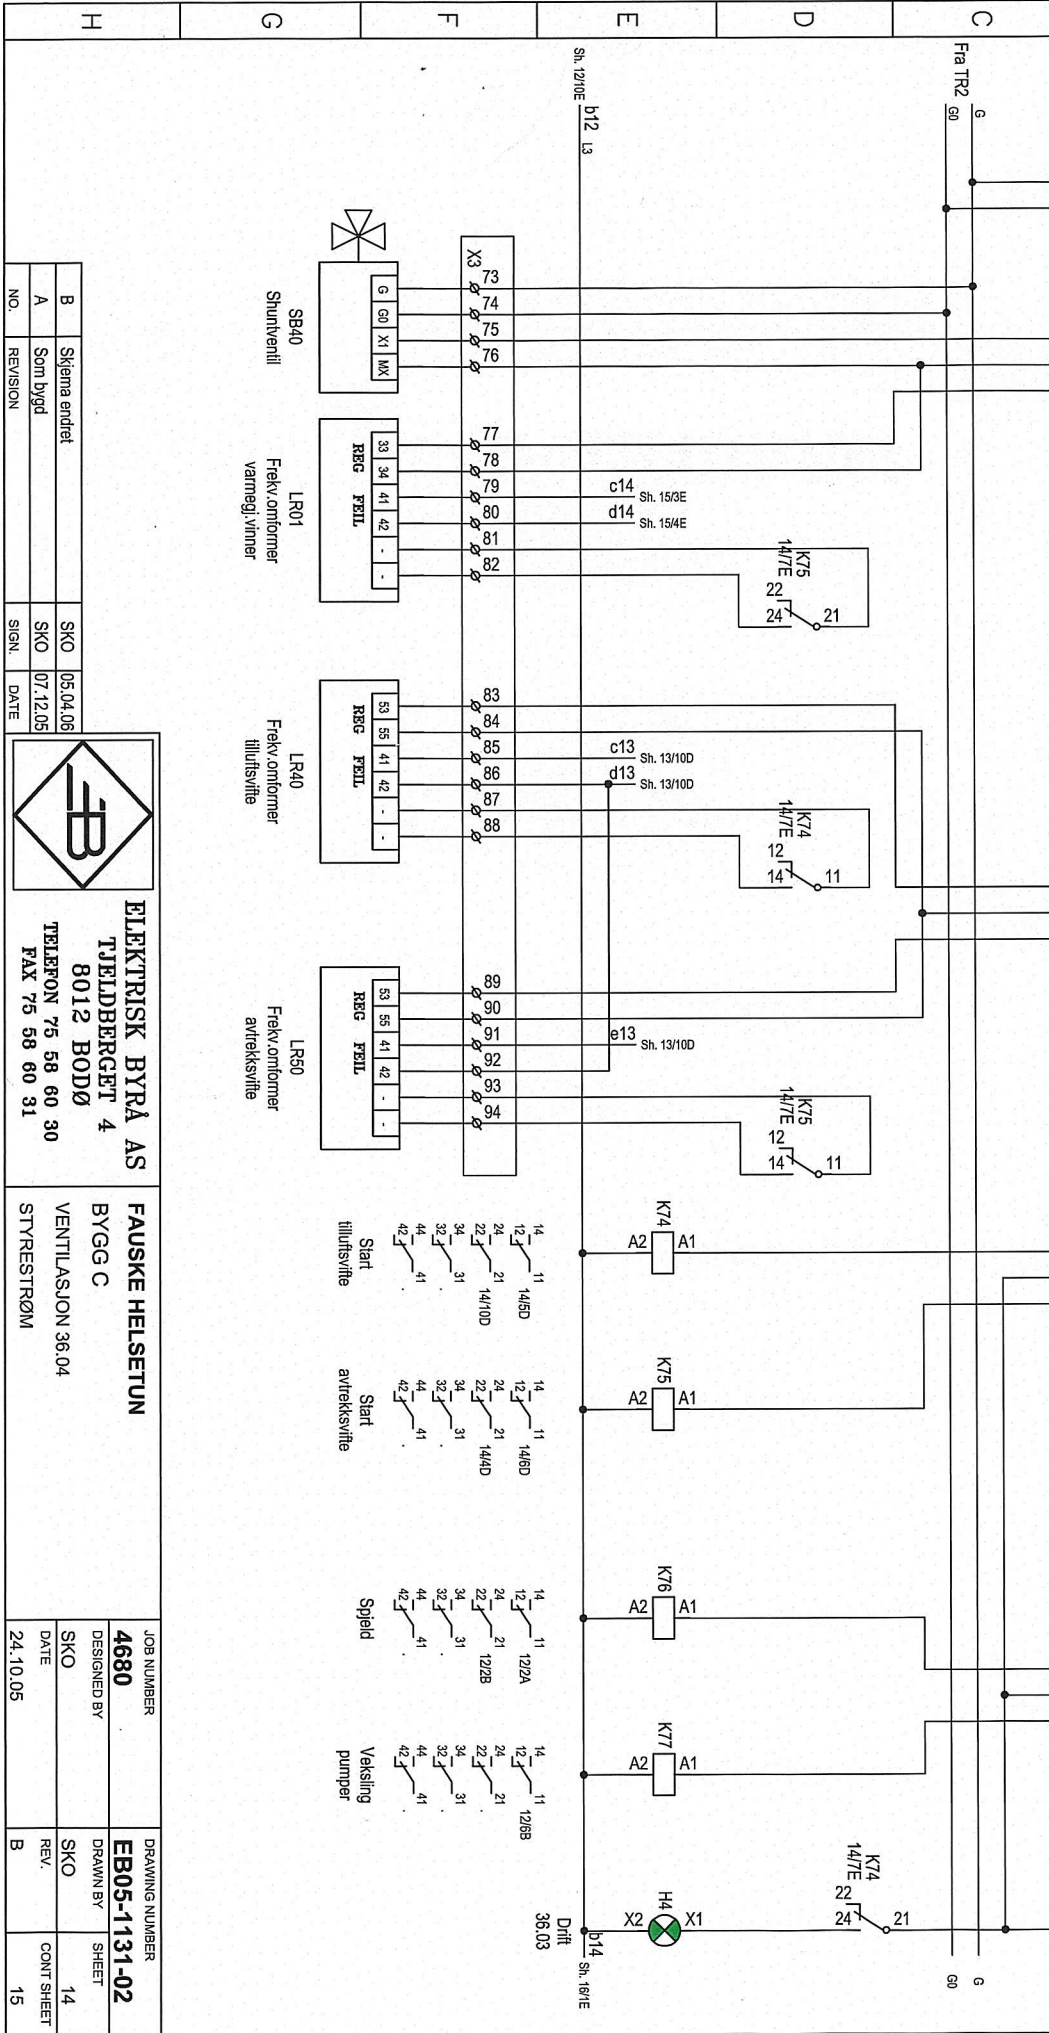

ELEKTRISK BYRÅ AS		FAUSKE HELSETUN		JOB NUMBER		DRAWING NUMBER	
TJELDBERGGET 4		BYGG C		4680		EB05-1131-02	
8012 BODØ		VENTILASJON 36.04		DESIGNED BY		DRAWN BY	
TELEFON 75 58 60 30		STYRESTRØM		SKO		SKO	
FAX 75 58 60 31				DATE		REV.	
				24.10.05		B	
						SHEET	
						14	
						CONT SHEET	
						15	

			G GO		24VAC
			C1 C2		COM
			UNI. INN 1 M UNI. INN 2		
			UNI. INN 3 M UNI. INN 4		
			0-10VDC AUT 1 M 0-10VDC AUT 2		
			TERM. INN 1 M TERM. INN 2		
			TERM. INN 3 M TERM. INN 4		

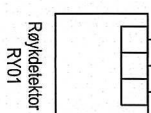

	ELEKTRISK BYRÅ AS TJELDBERGGET 4 8012 BODØ TELEFON 75 58 60 30 FAX 75 58 60 31		FAUSKE HELSETUN BYGG C VENTILASJON 36.04 STYRESTRØM	
	JOB NUMBER 4680		DRAWING NUMBER EB05-1131-02	
	DESIGNED BY SKO	DRAWN BY SKO	SHEET 15	CON'T SHEET 16
	DATE 24.10.05	REV. B		