


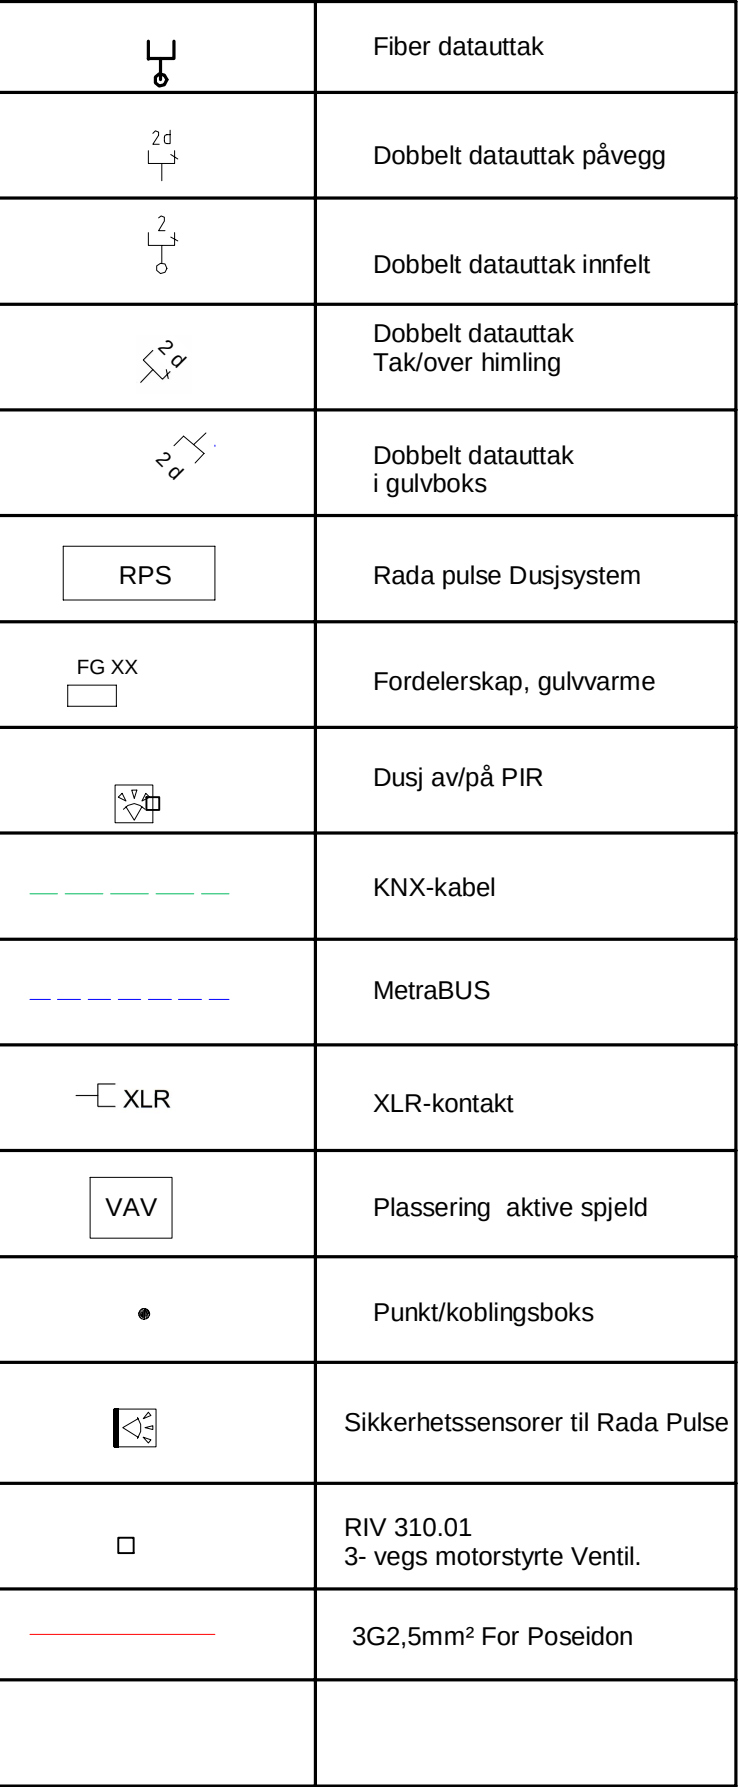

Z - G	Som byttet					01.11.2019	KBL	JN		
Rev.	Tekst					Rev.date:	Tegn.	Ky.		

		
Projekt Trømsbøadet		
Opretningsnr. Trømsø kommune, Utbyggingstjenesten		
Tele og Autom. Plan 2 Del 1		
Opretningsnr. Rune Langseth 543223-01	Korteplannummer NTM 18 18000000 NN 54	Målestokk 1:50 1:50 A0
Tegnr.: 25-500-1 Fig. Type Ety. Løsnr.	Rev. Z-01	