


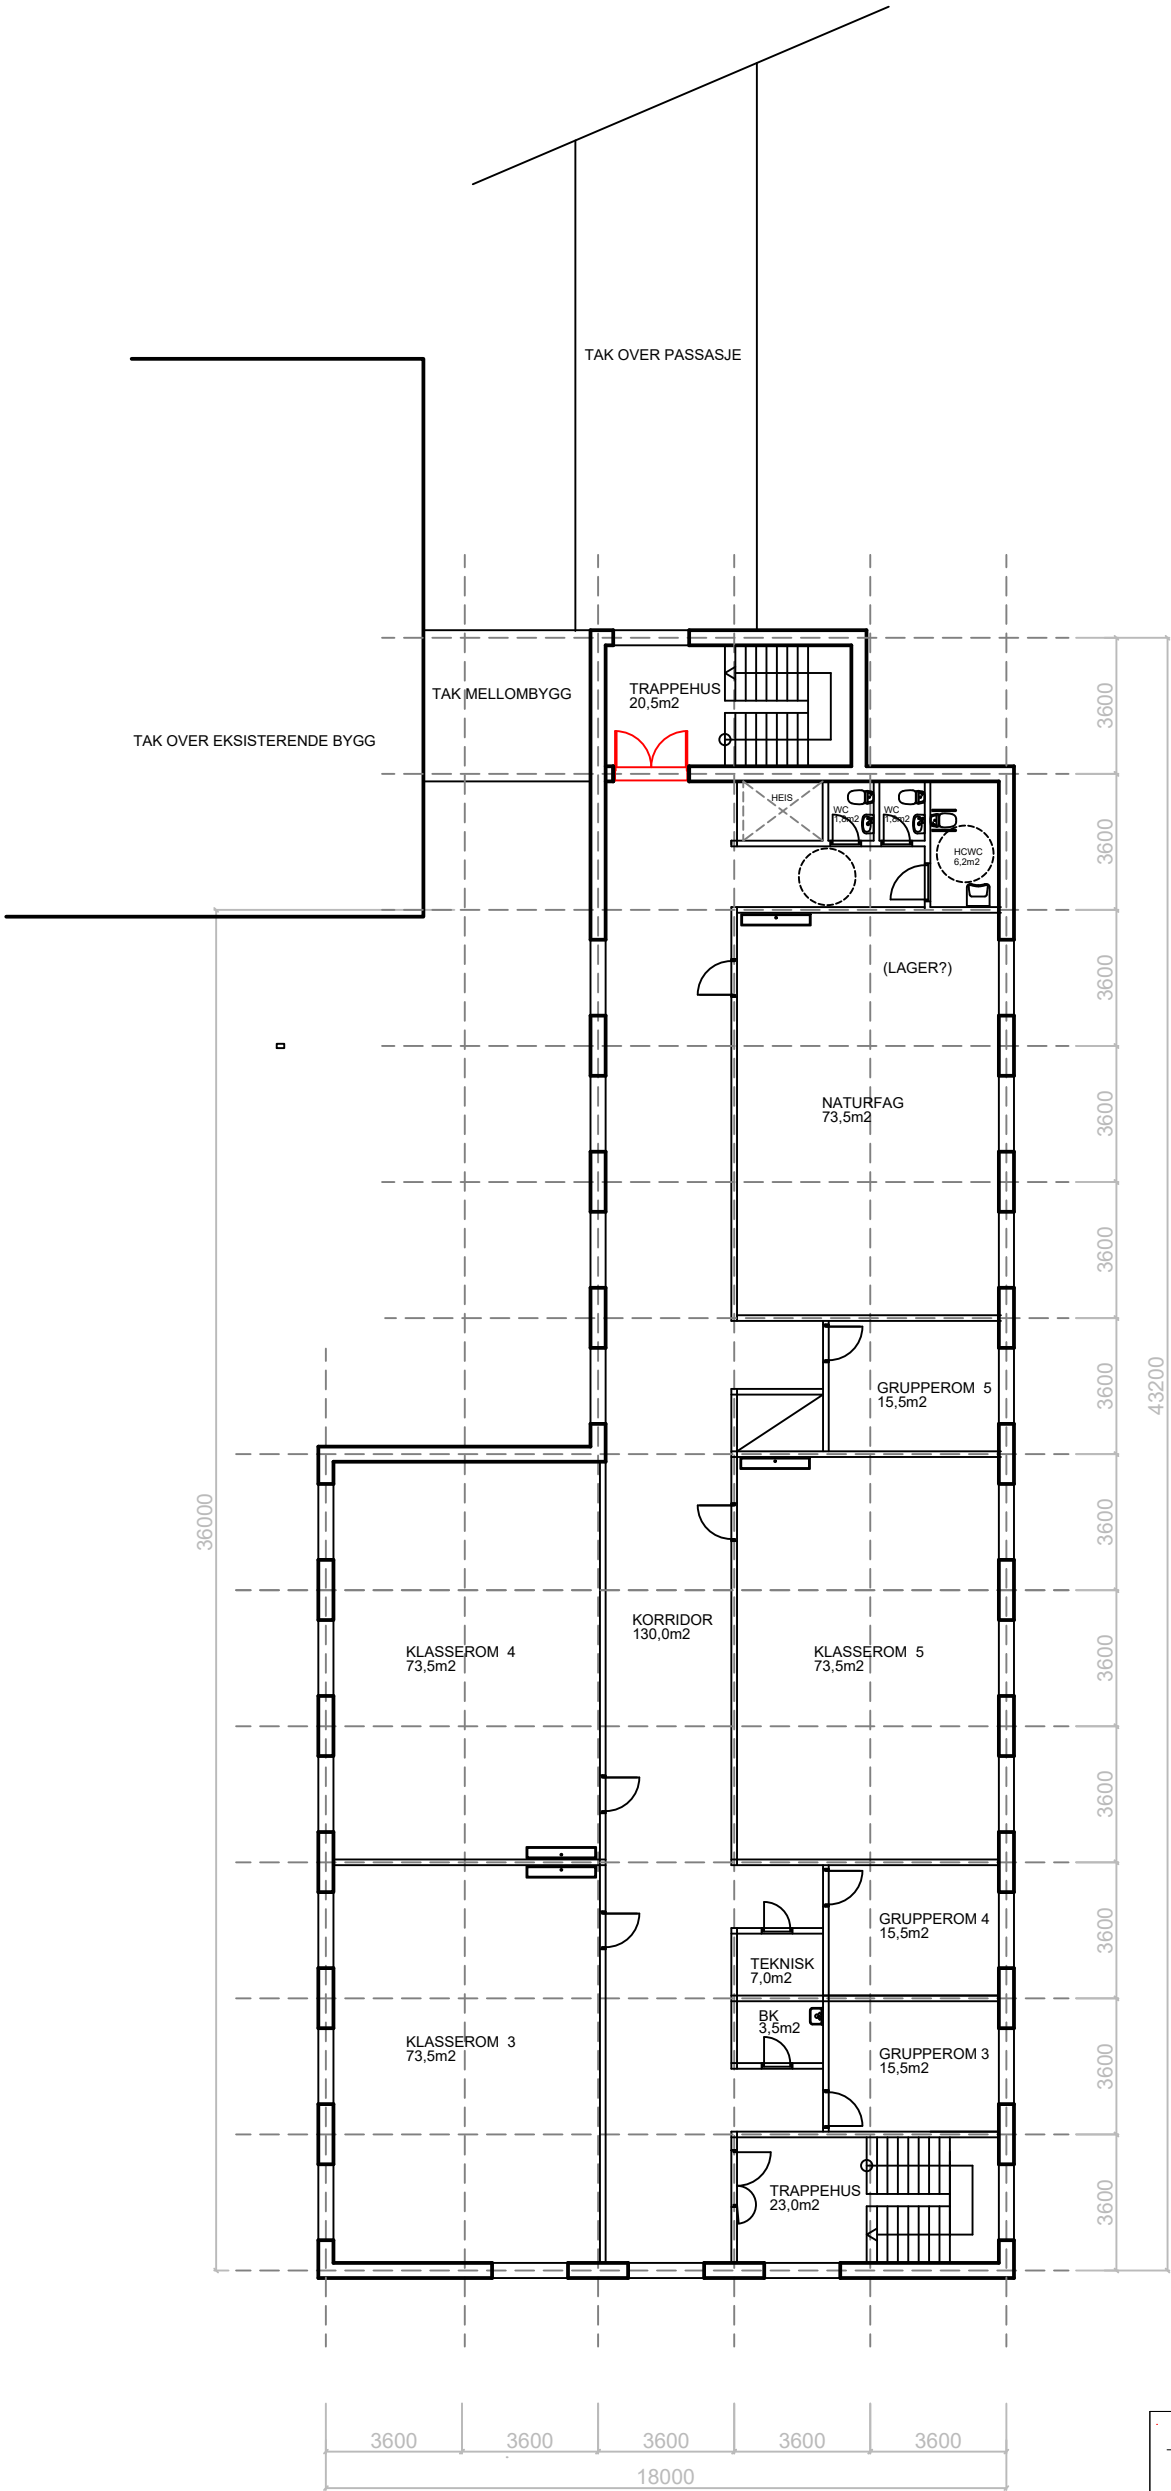

PLAN 2
ca 634m2 BTA