


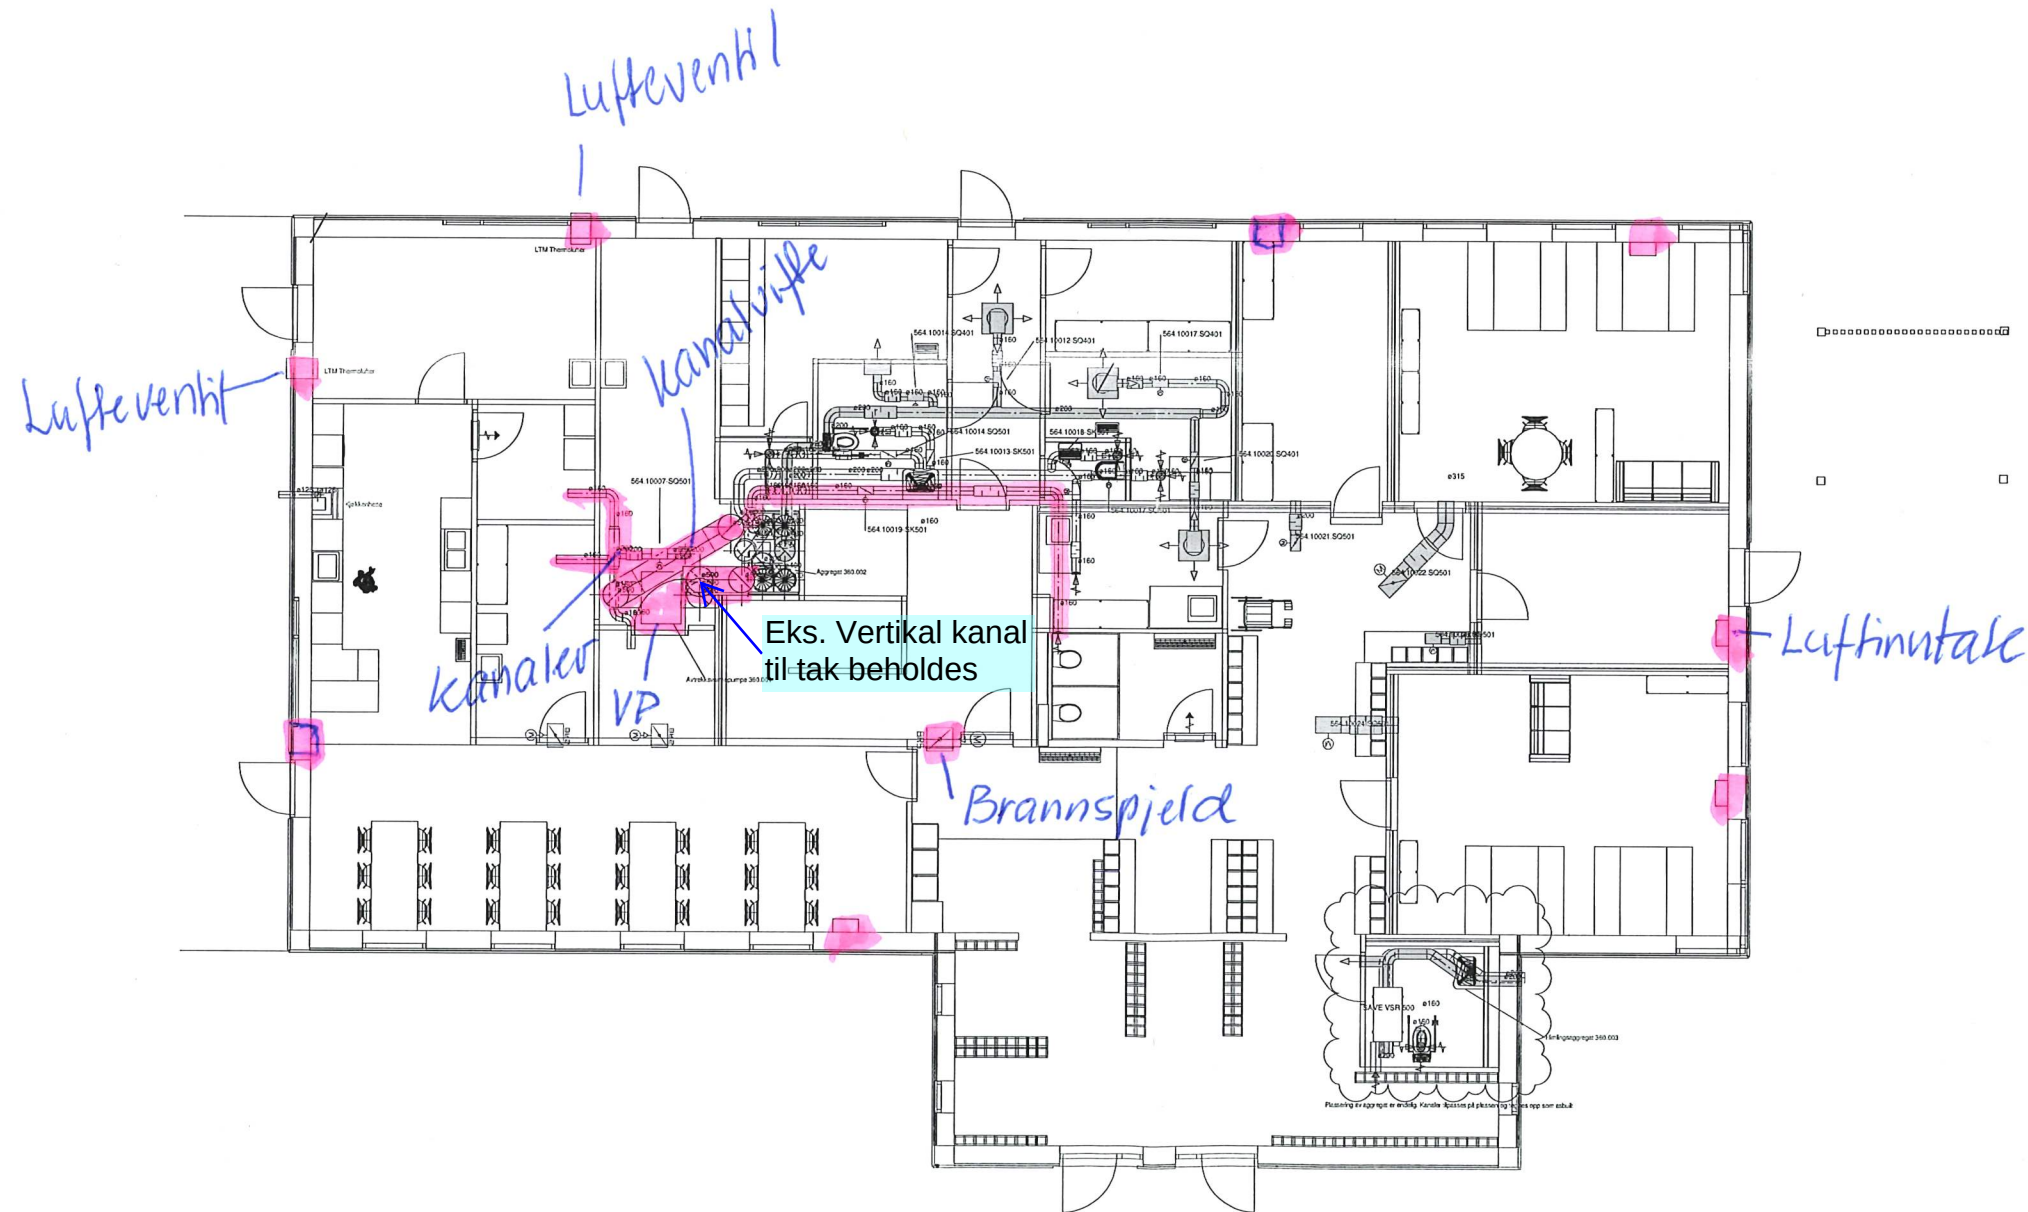


Rives

Notes:

Form: 1-1000

☐ VAV-CAT app
☐ Brevspjeld
☐ Lysbryter

Arbeids tegning	
 Rindem & Høiberg AS Skrevet av: I Verifisert av: K Dato: 2023-12-12	
CON ROL	
Tegning nr.: 215-001 360.00 - VENT Plan 1	
215-001 1	1

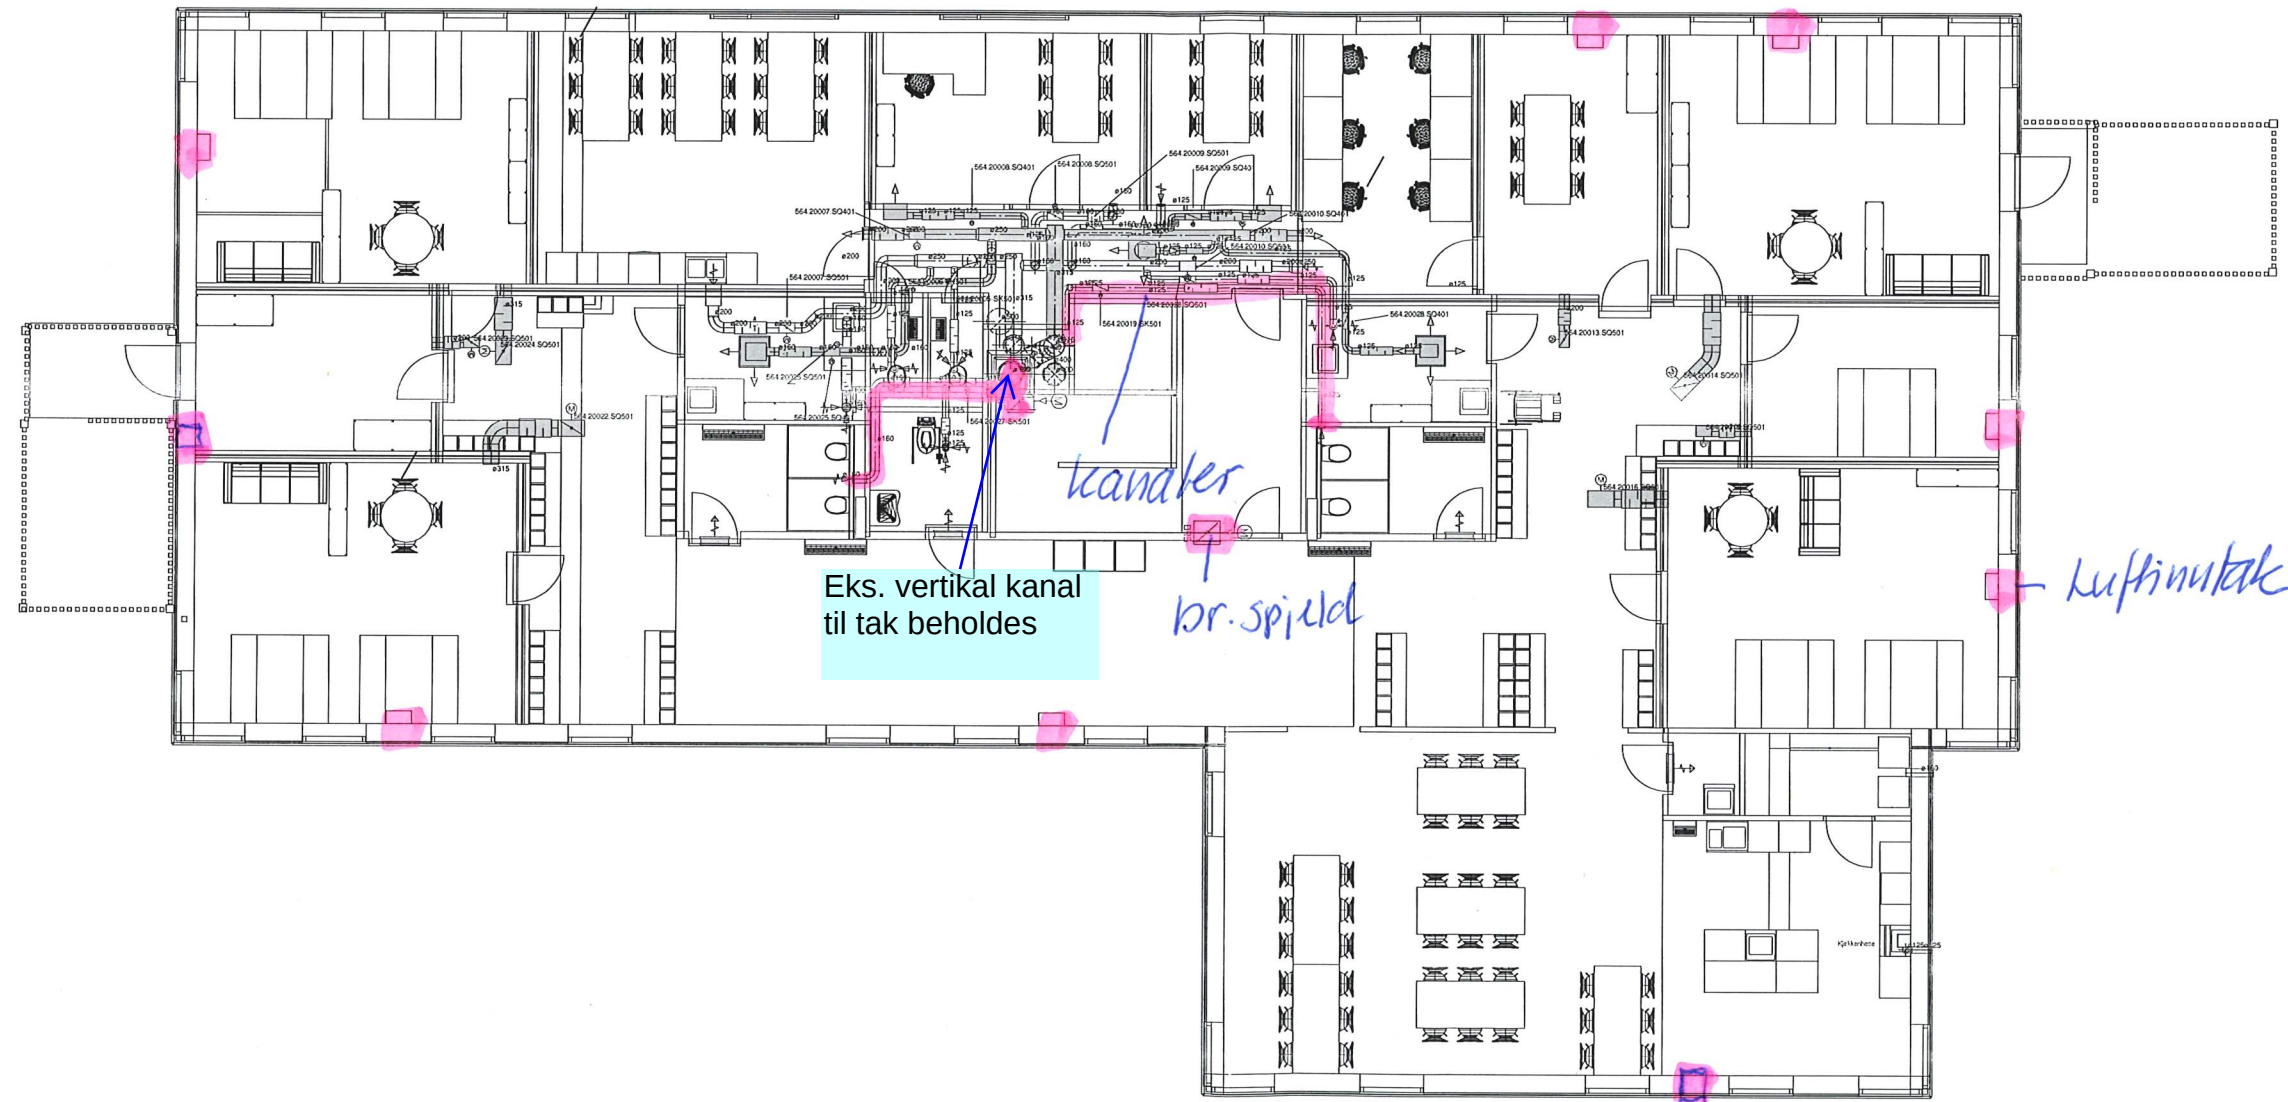

Eks. vertikal kanal
til tak beholdes

kanaler
br. spjæld


Rives

Notes:

Scale: 1:1000

Legend:


CON ROL			
360.00 - VENT Plan 2 215001			