


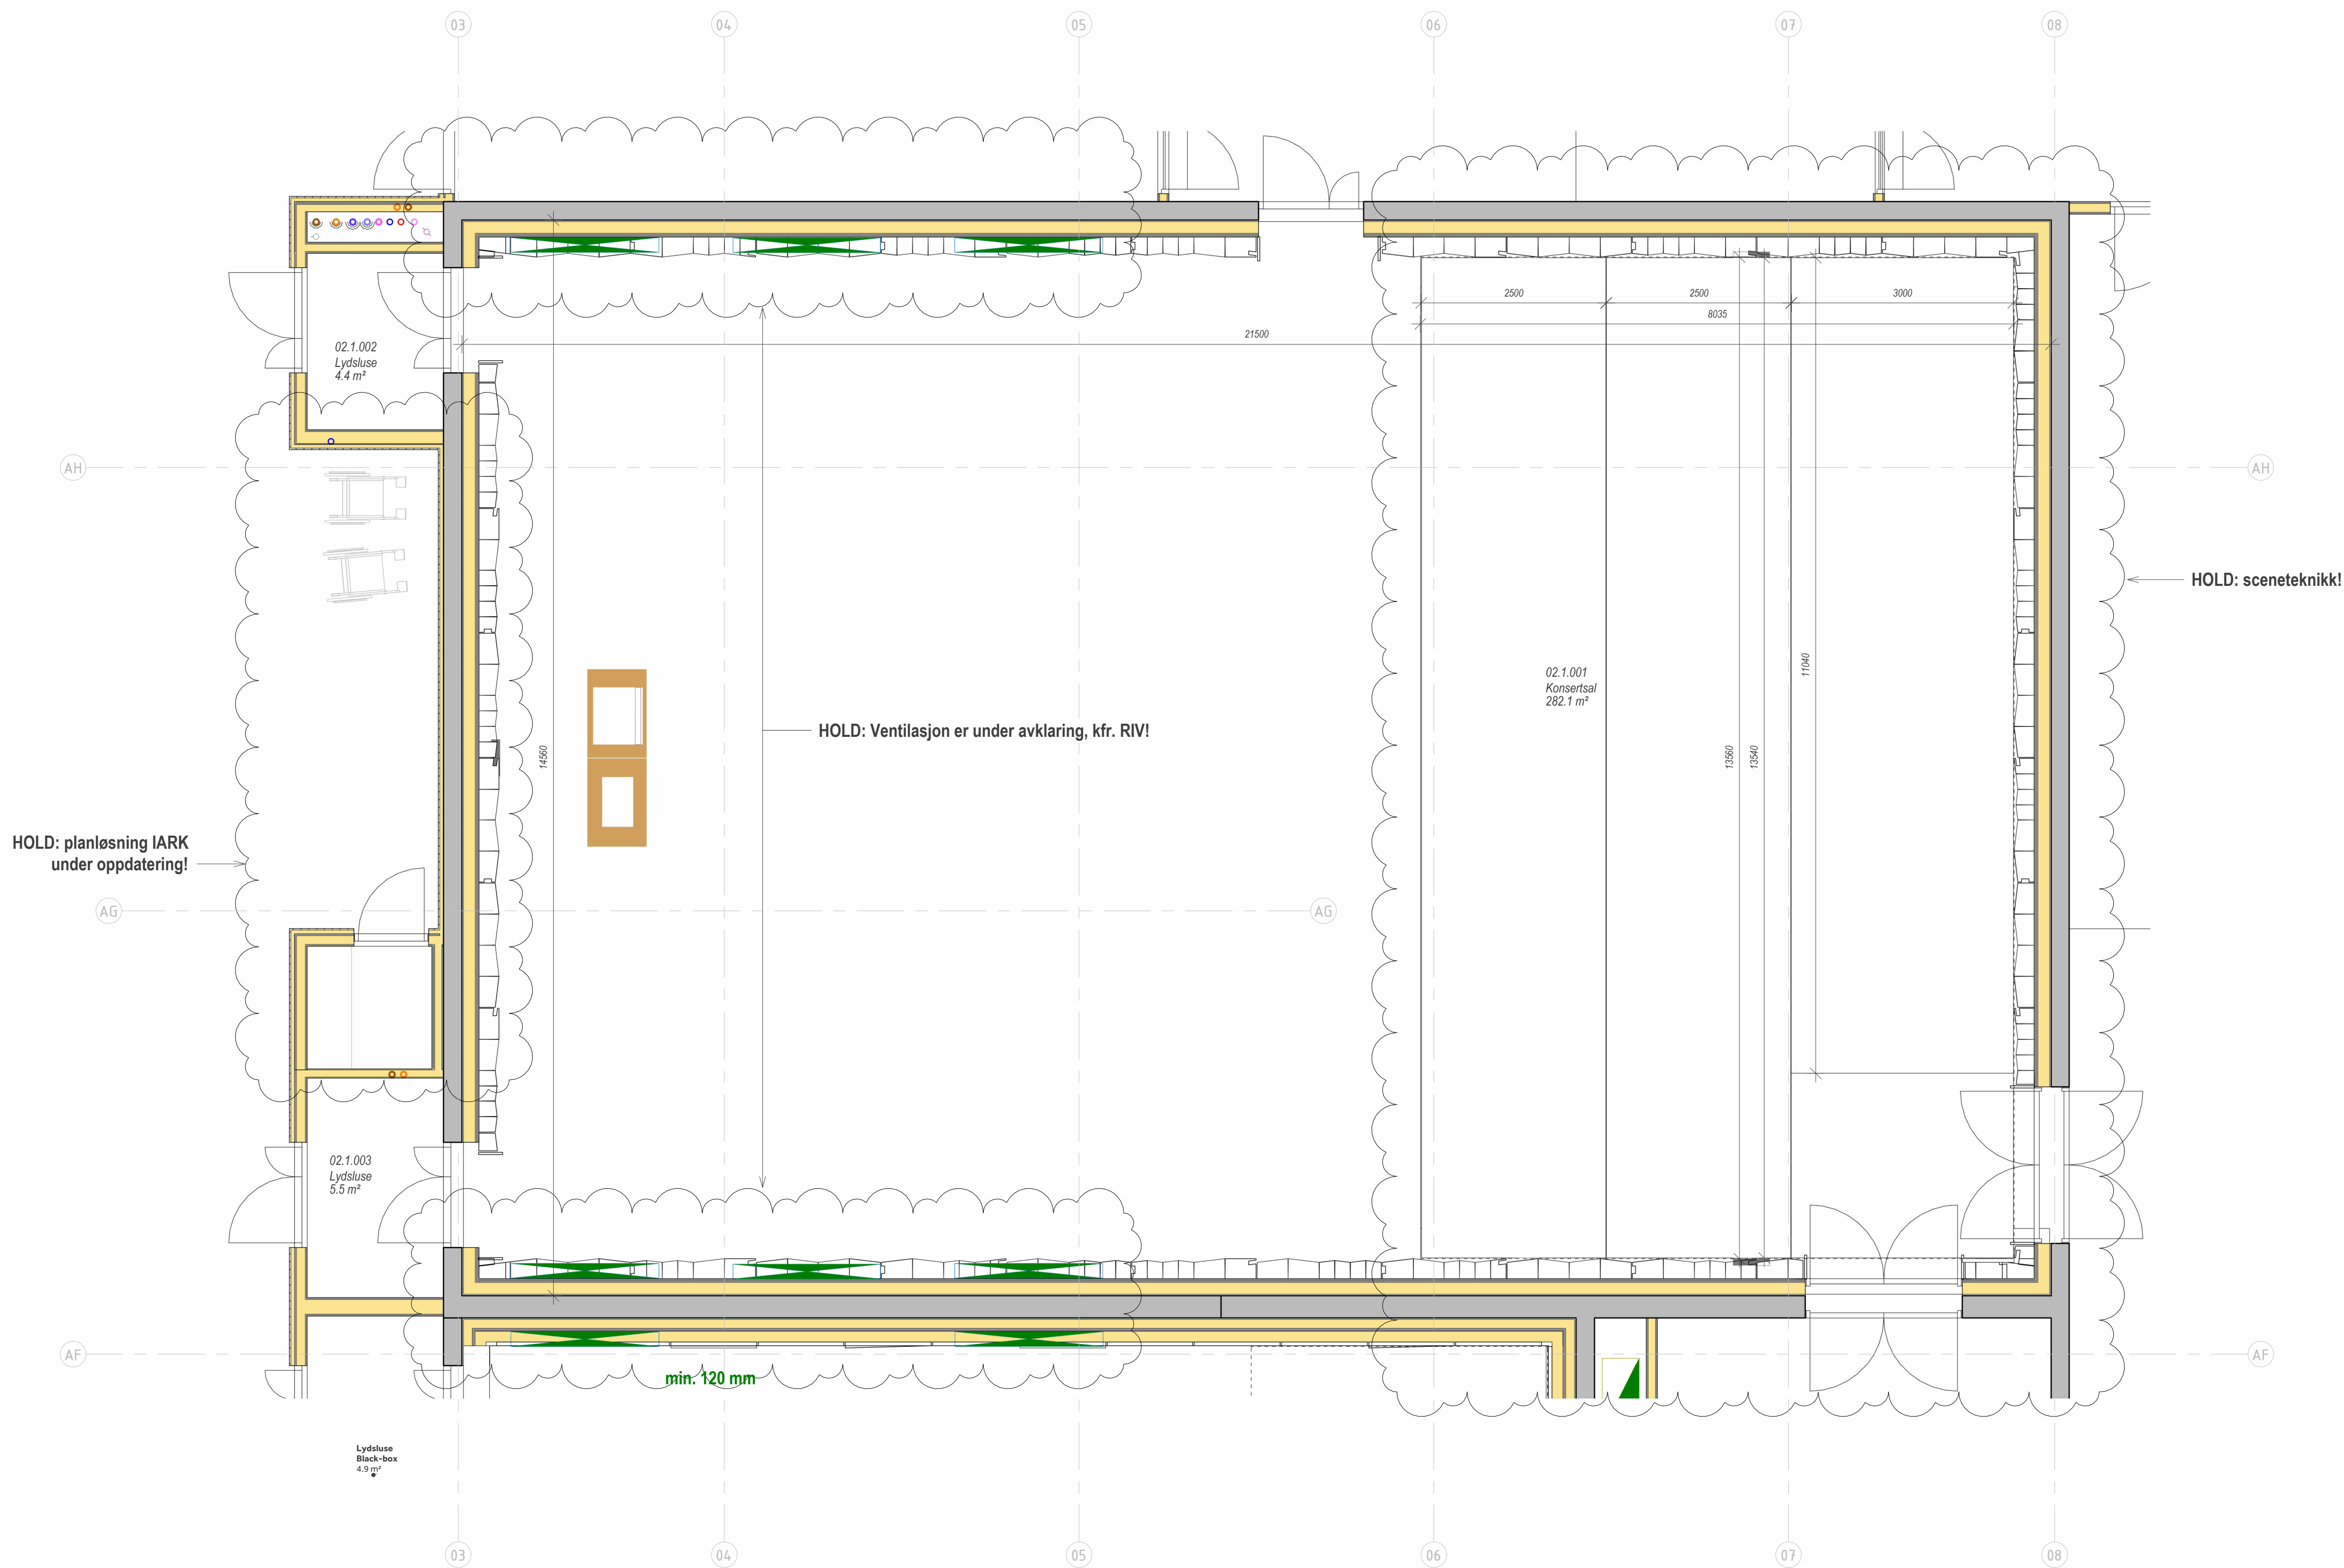


Foreløpig

09.10.2026 13:44:41


Prosjekteringsgruppen:

- ARK : Nordic Office of Architecture
- RIB : NORCONSULT AS
- RIE : NORCONSULT AS
- RIV : NORCONSULT AS
- RIAKu : NORCONSULT AS
- RIG : NORCONSULT AS
- RIBr : NORCONSULT AS
- LARK : NORCONSULT AS
- RIVA : VEIDEKKE AS
- RIVEG : VEIDEKKE AS

Firma logo:

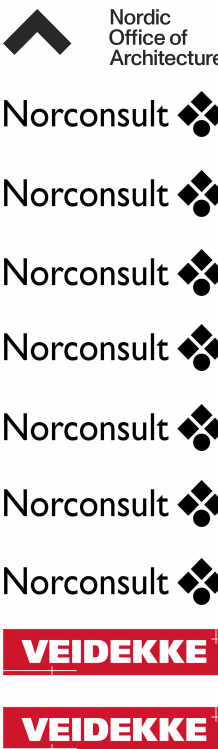

Lokaliseringsfigur:

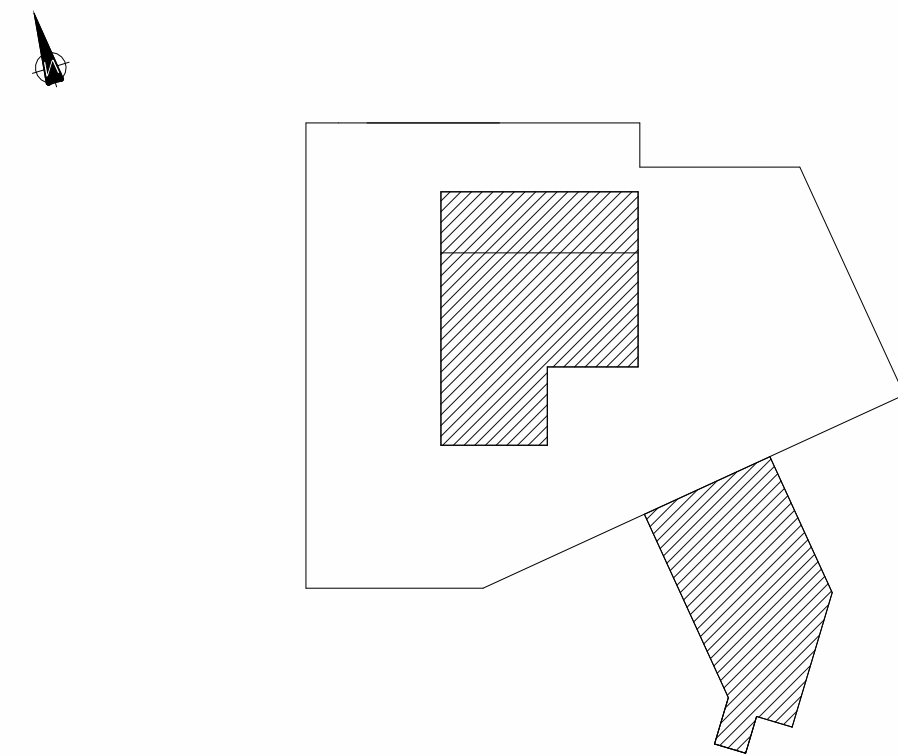

Fase: 4.1 Detaljprosjekt

		PROSJEKTNR. SB: 1122003	
Tittel:		Godkjent	
Griegakademiet		Kontroll prosjekt:	
		Sign.	Kontroll
Skjema konsertsal		Dato	
		Målestokk	Format
Plan 01		1 : 50	A1
		Kontroll utførende	Kontroll
SB Tegningsnummer:		Prosjektnr. for prosjekterende/rev.	
Eiendomsnummer	Byggsnummer	Etasje	Fag
Systemkode	Type tegn.	Leppnr.	Prosj fase
Rev.	Status		
13804-115454-01-A-200-63-111		4.1	
		I	
		220214	