


Lars Martin Jøger, Utskrift 95833635

Aremark kommune

Aremark Stadion

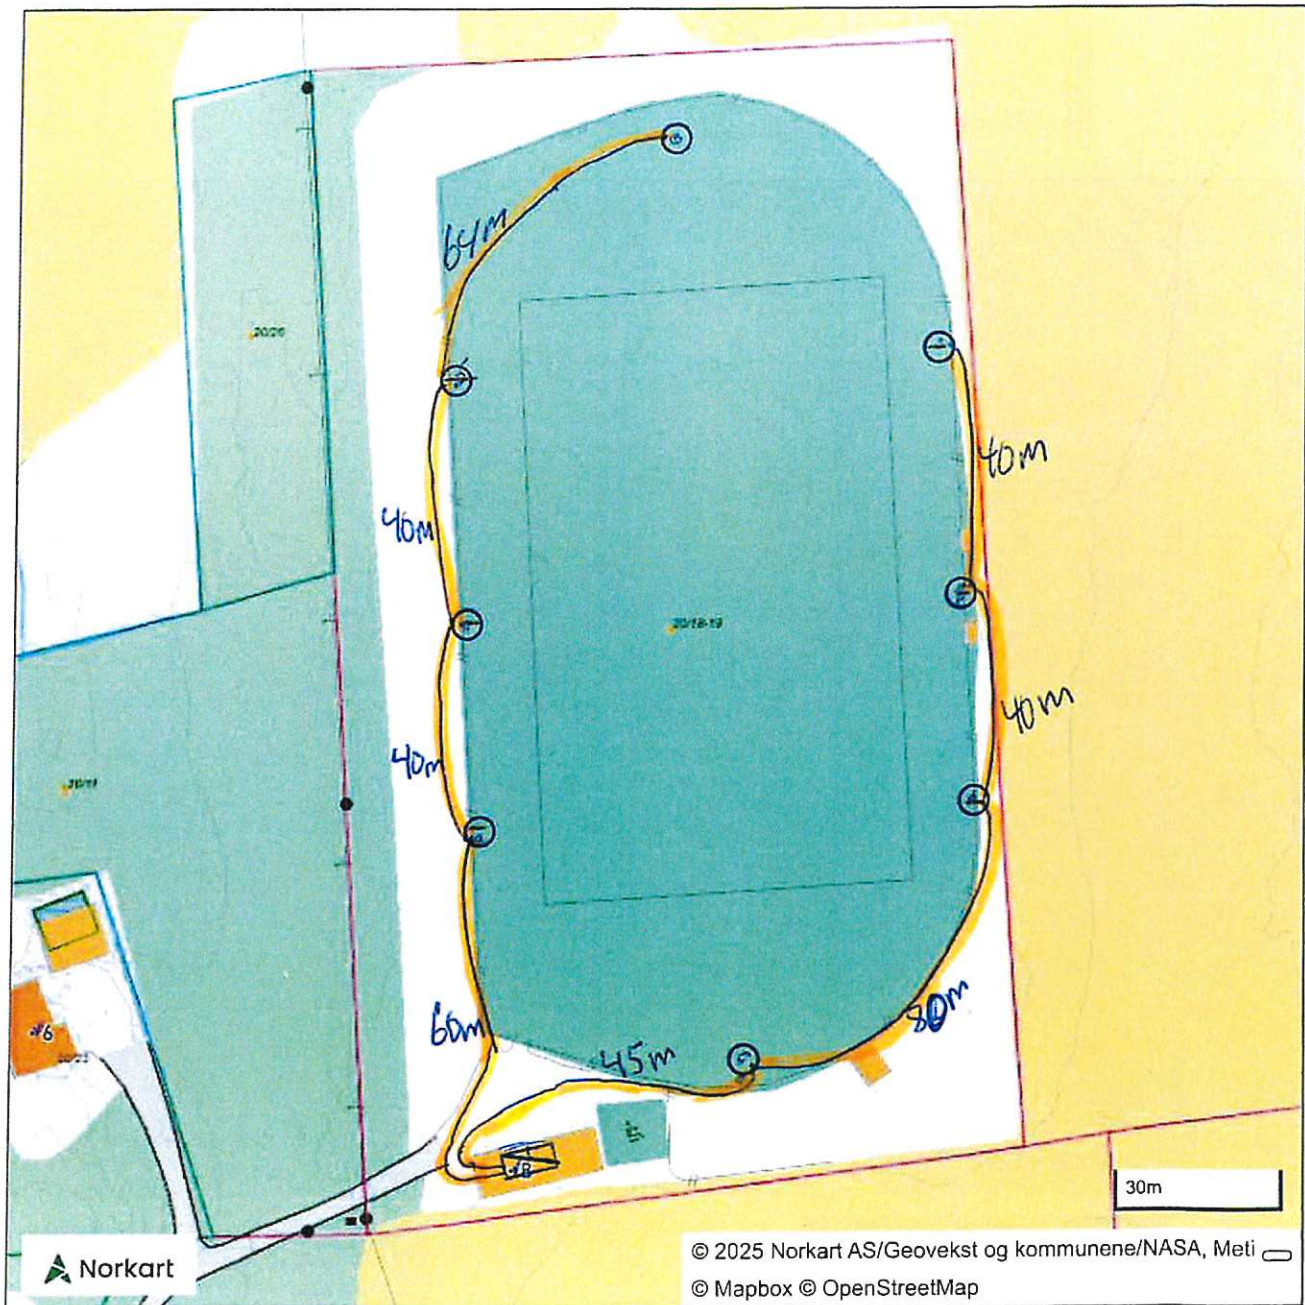

$$14 \text{armaturer} \text{ à } 973 \text{ W} = 13622 \text{ W}$$

$$\text{Kurs 1: } L = 228 \text{ m, } 7 \text{armaturer: } 6811 \text{ W}$$

$$\text{Kurs 2: } L = 229 \text{ m, } 7 \text{armaturer: } 6811 \text{ W}$$

$$L = 457 \text{ m}$$

$$\approx 475 \text{ m}$$